

WATER WELL RECORD


Form WWC-5

Division of Water Resources App. No.

1 LOCATION OF WATER WELL: County: Brown Fraction SW 1/4 SW 1/4 SE 1/4 NE 1/4 Section Number 8 Township No. T 2 S Range Number R 17 E W

Street/Rural Address of Well Location; if unknown, distance & direction from nearest town or intersection: 1/2 mile south & 950 feet west of 270th St & HY73. Global Positioning System (GPS) information: Latitude: 39.892444 Longitude: -95.530805 Elevation: 1062

2 WATER WELL OWNER: Kenneth Babcock RR#, Street Address, Box #: 1858 220th St. City, State, ZIP Code : Hiawatha, KS 66434 Collection Method: GPS unit (Make/Model: Garmin 12xl)

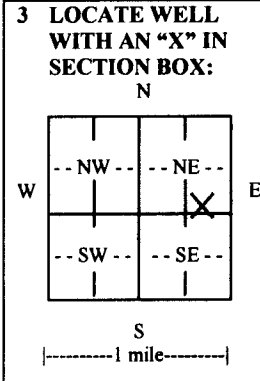

3 LOCATE WELL WITH AN 'X' IN SECTION BOX: 4 DEPTH OF COMPLETED WELL 59 ft. Depth(s) Groundwater Encountered (1) 29 ft. (2) ft. (3) ft. WELL'S STATIC WATER LEVEL 29.7 ft. below land surface measured on mo/day/yr. Pump test data: Well water was ft. after hours pumping gpm EST. YIELD 120 gpm. Well water was ft. after hours pumping gpm Bore Hole Diameter 14 in. to 59 ft., and in. to ft. WELL WATER TO BE USED AS: Irrigation, Domestic, Feedlot, Oil field water supply, Dewatering, Other (Specify below)

5 TYPE OF CASING USED: Steel, PVC, Other. CASING JOINTS: Glued, Clamped, Welded, Threaded. Casing diameter 8 in. to 59 ft., Diameter in. to ft., Diameter in. to ft. Casing height above land surface 24 in., Weight 7.07 lbs./ft., Wall thickness or gauge No. 0.41. TYPE OF SCREEN OR PERFORATION MATERIAL: Steel, Stainless Steel, PVC, Brass, Galvanized Steel, None used (open hole). SCREEN OR PERFORATION OPENINGS ARE: Continuous slot, Mill slot, Gauze wrapped, Torch cut, Drilled holes, None (open hole), Louvered shutter, Key punched, Wire wrapped, Saw cut, Other (specify). SCREEN-PERFORATED INTERVALS: From 39 ft. to 59 ft., From ft. to ft., From ft. to ft. GRAVEL PACK INTERVALS: From 25 ft. to 59 ft., From ft. to ft., From ft. to ft.

6 GROUT MATERIAL: Neat cement, Cement grout, Bentonite, Other. Grout Intervals: From 5 ft. to 25 ft., From ft. to ft., From ft. to ft. What is the nearest source of possible contamination: Septic tank, Lateral lines, Pit privy, Livestock pens, Insecticide storage, Other (specify below), Sewer lines, Cesspool, Sewage lagoon, Fuel storage, Abandoned water well, Watertight sewer lines, Seepage pit, Feedyard, Fertilizer storage, Oil well/gas well, Sand Pit. Direction from well North. Distance from well 300'.

Table with columns: FROM, TO, LITHOLOGIC LOG, FROM, TO, LITHO. LOG (cont.) or PLUGGING INTERVALS. Rows: 0-5 no sample, 5-12 clay silty brown, 12-16 sand M, 16-30 sand M with clay layers, 30-54 sand and coarse gravel, 54-64 shale gray, 64 limestone.

7 CONTRACTOR'S OR LANDOWNER'S CERTIFICATION: This water well was constructed, reconstructed, or plugged under my jurisdiction and was completed on (mo/day/year) 02/23/2011. Kansas Water Well Contractor's License No. 779. This Water Well Record was completed on (mo/day/year) 05/11/2011 under the business name of Drill-Well, LLC by (signature) [Signature]

INSTRUCTIONS: Use typewriter or ball point pen. PLEASE PRESS FIRMLY and PRINT clearly. Please fill in blanks and check the correct answers. Send three copies (white, blue, pink) to Kansas Department of Health and Environment, Bureau of Water, Geology Section, 1000 SW Jackson St., Suite 420, Topeka, Kansas 66612-1367. Telephone 785-296-5522. Send one copy to WATER WELL OWNER and retain one for your records. Include fee of \$5.00 for each constructed well. Visit us at http://www.kdheks.gov/waterwell/index.html.