


1 LOCATION OF WATER WELL: County: Brown Fraction SW 1/4 NW 1/4 NW 1/4 Section Number 28 Township Number T 2 S Range Number R 17 E/W

Distance and direction from nearest town or city street address of well if located within city? 100 Oregon, Hiawatha

2 WATER WELL OWNER: Kloepper, Inc. RR#, St. Address, Box #: Box 123 City, State, ZIP Code: Hiawatha, Kansas 66434 Board of Agriculture, Division of Water Resources Application Number:

3 LOCATE WELL'S LOCATION WITH AN "X" IN SECTION BOX:

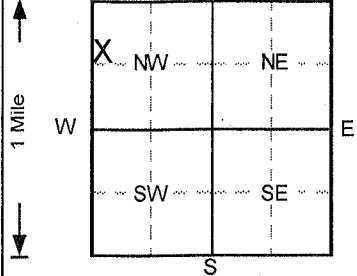

4 DEPTH OF COMPLETED WELL: 65 ft. ELEVATION: ... WELL'S STATIC WATER LEVEL: 64.83 ft. below land surface measured on mo/day/yr 1/9/2014 Pump test data: Well water was NA ft. after ... hours pumping ... gpm Est. Yield NA gpm: Well water was ... ft. after ... hours pumping ... gpm Bore Hole Diameter 8 in. to 65 ft., and ... in. to ... ft. WELL WATER TO BE USED AS: 10 Monitoring well

5 TYPE OF BLANK CASING USED: 2 PVC Blank casing diameter .2 in. to 35 ft., Dia ... in. to ... ft., Dia ... in. to ... ft. Casing height above land surface ... in., weight ... lbs./ft. Wall thickness or gauge No. Sch. 40 TYPE OF SCREEN OR PERFORATION MATERIAL: 7 PVC SCREEN OR PERFORATION OPENINGS ARE: 3 Mill slot SCREEN-PERFORATED INTERVALS: From 35 ft. to 65 ft. GRAVEL PACK INTERVALS: From 33 ft. to 65 ft.

6 GROUT MATERIAL: 3 Bentonite 4 Other Concrete Grout intervals: From 0 ft. to 1 ft., From 1 ft. to 35 ft., From ... ft. to ... ft. What is the nearest source of possible contamination: 10 Livestock pens 14 Abandoned water well 15 Fuel storage 15 Oil well/Gas well 16 Other (specify below)

Direction from well? LITHOLOGIC LOG: FROM TO CLAY, SILTY, DARK BROWN 0 4 CLAY, SILTY, DARK BROWN 4 6 CLAY, SL. SILTY, BROWN 6 16 CLAY, SL. SILTY, LT. BROWN 16 24 CLAY, SL. SILTY, BROWN 24 35 CLAY, SILTY, LT. BROWN TO YELLOW BROWN 35 52 CLAY, SL. SILTY, LT. BROWN TO YELLOW BROWN 52 60 CLAY, YELLOW BROWN w/white calc. mat. 60 65 PLUGGING INTERVALS: MW11, Flushmount

7 CONTRACTOR'S OR LANDOWNER'S CERTIFICATION: This water well was (1) constructed, (2) reconstructed, or (3) plugged under my jurisdiction and was completed on (mo/day/year) 1/9/2014 and this record is true to the best of my knowledge and belief. Kansas Water Well Contractor's License No. 527. This Water Well Record was completed on (mo/day/yr) 1/10/2014 under the business name of GeoCore, Inc. by (signature) [Signature]

INSTRUCTIONS: Use typewriter or ball point pen. PLEASE PRESS FIRMLY and PRINT clearly. Please fill in blanks, underline or circle the correct answers. Send top three copies to Kansas Department of Health and Environment, Bureau of Water, Topeka, Kansas 66620-0001. Telephone: 913-296-5545. Send one to WATER WELL OWNER and retain one for your records.