


1 LOCATION OF WATER WELL: County: BROWN Fraction: NW 1/4 SE 1/4 NE 1/4 Section Number: 29 Township Number: T 2 S Range Number: R 17 E

Distance and direction from nearest town or city street address of well if located within city?  
~ 80 FT east in Alley off of 5th St., between Oregon St and Utah St.; behind library

2 WATER WELL OWNER: City of Hiawatha Attn: Steve King  
 RR#, St. Address, Box #: 723 Oregon Board of Agriculture, Division of Water Resources  
 City, State, ZIP Code: Hiawatha, KS 66434 Application Number:

3 LOCATE WELL'S LOCATION WITH AN "X" IN SECTION BOX:

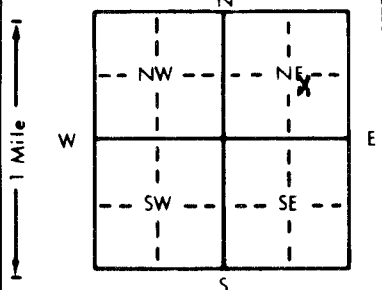

4 DEPTH OF COMPLETED WELL: 35.0 ft. ELEVATION:

Depth(s) Groundwater Encountered 1. 28.0 ft. 2. — ft. 3. — ft.

WELL'S STATIC WATER LEVEL: 4.91 ft. below land surface measured on mo/day/yr 7-27-94

Pump test data: Well water was — ft. after — hours pumping — gpm

Est. Yield — gpm; Well water was — ft. after — hours pumping — gpm

Bore Hole Diameter: 0.625 in. to 35.0 ft., and — in. to — ft.

WELL WATER TO BE USED AS: 5 Public water supply 8 Air conditioning 11 Injection well

1 Domestic 3 Feedlot 6 Oil field water supply 9 Dewatering 12 Other (Specify below)

2 Irrigation 4 Industrial 7 Lawn and garden only 10 Monitoring well

Was a chemical/bacteriological sample submitted to Department? Yes — No X; If yes, mo/day/yr sample was submitted

Water Well Disinfected? Yes — No X

5 TYPE OF BLANK CASING USED: 1 Steel 3 RMP (SR) 5 Wrought iron 8 Concrete tile CASING JOINTS: Glued — Clamped —

2 PVC 4 ABS 7 Fiberglass 9 Other (specify below) Welded — Threaded X

Blank casing diameter: 2 in. to 19.4 ft. Dia — in. to — ft. Dia — in. to — ft.

Casing height above land surface: Flush mounted in. weight sch 40 lbs./ft. Wall thickness or gauge No. —

TYPE OF SCREEN OR PERFORATION MATERIAL: 1 Steel 3 Stainless steel 5 Fiberglass 8 RMP (SR) 10 Asbestos-cement

2 Brass 4 Galvanized steel 6 Concrete tile 9 ABS 11 Other (specify) —

SCREEN OR PERFORATION OPENINGS ARE: 1 Continuous slot 3 Mill slot 5 Gauzed wrapped 8 Saw cut 11 None (open hole)

2 Louvered shutter 4 Key punched 7 Torch cut 9 Drilled holes 10 Other (specify) —

SCREEN-PERFORATED INTERVALS: From 19.4 ft. to 34.4 ft. From — ft. to — ft.

From — ft. to — ft. From — ft. to — ft.

SAND GRAVEL PACK INTERVALS: From 17.0 ft. to 35.0 ft. From — ft. to — ft.

From — ft. to — ft. From — ft. to — ft.

6 GROUT MATERIAL: 1 Neat cement 2 Cement grout 3 Bentonite 4 Other

Grout Intervals: From GL ft. to 15 ft. From 15 ft. to 17 ft. From — ft. to — ft.

What is the nearest source of possible contamination: 1 Septic tank 4 Lateral lines 7 Pit privy 10 Livestock pens 14 Abandoned water well

2 Sewer lines 5 Cess pool 8 Sewage lagoon 11 Fuel storage 15 Oil well/Gas well

3 Watertight sewer lines 6 Seepage pit 9 Feedyard 12 Fertilizer storage 16 Other (specify below) Contaminated site U.S.T.'s

Direction from well? SE How many feet? ~110 FT

FROM	TO	LITHOLOGIC LOG	FROM	TO	PLUGGING INTERVALS
GL	3.0	Fill - silt, clays, concrete			
3.0	28	Silty clay - grey to brown, trace sand, stiff			
28	31	Clayey sand, fine grain, saturated			
31	35	Alternating units of limestone and shale			
35	TD				

**FLUSH MOUNT WAIVER**  
**DON TAYLOR 07-19-94**

7 CONTRACTOR'S OR LANDOWNER'S CERTIFICATION: This water well was (1) constructed, (2) reconstructed, or (3) plugged under my jurisdiction and was completed on (mo/day/year) 07-26-94 and this record is true to the best of my knowledge and belief. Kansas

Water Well Contractor's License No. 479 This Water Well Record was completed on (mo/day/yr) 08-08-94

under the business name of EBBERS DRILLING by (signature) Gregory Ellety