


1 LOCATION OF WATER WELL: County: Brown Fraction: SW 1/4 NE 1/4 NW 1/4 Section Number: 29 Township Number: T 2 S Range Number: R 17 E

Distance and direction from nearest town or city street address of well if located within city? in town MW 5

2 WATER WELL OWNER: Brown County Cooperative
 RR#, St. Address, Box #: 900 Oregon Board of Agriculture, Division of Water Resources
 City, State, ZIP Code: Hiawatha, Ks. Application Number:

3 LOCATE WELL'S LOCATION WITH AN "X" IN SECTION BOX:

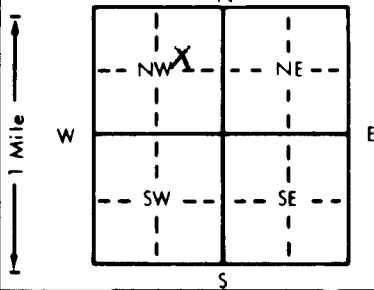

4 DEPTH OF COMPLETED WELL: 12.5 ft. ELEVATION:
 WELL'S STATIC WATER LEVEL: 4.10 ft. below land surface measured on mo/day/yr
 WELL WATER TO BE USED AS:
 1 Domestic 3 Feedlot 6 Oil field water supply 9 Dewatering 12 Other (Specify below)
 2 Irrigation 4 Industrial 7 Lawn and garden only 10 Monitoring well
 Was a chemical/bacteriological sample submitted to Department? Yes No; If yes, mo/day/yr sample was submitted 1
 Water Well Disinfected? Yes No

5 TYPE OF BLANK CASING USED:
 1 Steel 3 RMP (SR) 5 Wrought iron 8 Concrete tile CASING JOINTS: Glued 1 Clamped 1
2 PVC 4 ABS 6 Asbestos-Cement 9 Other (specify below) Welded
 7 Fiberglass Threaded
 Blank casing diameter 2 in. to 2.0 ft., Dia. 1 in. to 1 ft., Dia. 1 in. to 1 ft.
 Casing height above land surface 0 in., weight 1 lbs./ft. Wall thickness or gauge No. 1
 TYPE OF SCREEN OR PERFORATION MATERIAL:
 1 Steel 3 Stainless steel 5 Fiberglass 8 RMP (SR) 10 Asbestos-cement
 2 Brass 4 Galvanized steel 6 Concrete tile 9 ABS 11 Other (specify) 1
 12 None used (open hole)
 SCREEN OR PERFORATION OPENINGS ARE:
 1 Continuous slot 3 Mill slot 5 Gauzed wrapped 8 Saw cut 11 None (open hole)
 2 Louvered shutter 4 Key punched 6 Wire wrapped 9 Drilled holes
 7 Torch cut 10 Other (specify) 1
 SCREEN-PERFORATED INTERVALS: From 2.0 ft. to 12.5 ft., From 1 ft. to 1 ft., From 1 ft. to 1 ft.
 GRAVEL PACK INTERVALS: From 2.0 ft. to 12.5 ft., From 1 ft. to 1 ft., From 1 ft. to 1 ft.

6 GROUT MATERIAL: 1 Neat cement 2 Cement grout 3 Bentonite 4 Other
 Grout Intervals: From 0 ft. to 1.0 ft., From 1.0 ft. to 2.0 ft., From 2.0 ft. to 12.5 ft.
 What is the nearest source of possible contamination:
 1 Septic tank 4 Lateral lines 7 Pit privy 11 Fuel storage 14 Abandoned water well
 2 Sewer lines 5 Cess pool 8 Sewage lagoon 12 Fertilizer storage 15 Oil well/Gas well
 3 Watertight sewer lines 6 Seepage pit 9 Feedyard 13 Insecticide storage 16 Other (specify below)

Direction from well? How many feet?

FROM	TO	LITHOLOGIC LOG	FROM	TO	PLUGGING INTERVALS
<u>0</u>	<u>.50</u>	<u>Asphalt</u>			
<u>.50</u>	<u>12.5</u>	<u>clay, highly plastic, black moist</u>			

7 CONTRACTOR'S OR LANDOWNER'S CERTIFICATION: This water well was (1) constructed, (2) reconstructed, or (3) plugged under my jurisdiction and was completed on (mo/day/year) 7-14-94 and this record is true to the best of my knowledge and belief. Kansas Water Well Contractor's License No. 7738 This Water Well Record was completed on (mo/day/yr) 7/15/94 under the business name of Kansas City Trenching & Inc., by (signature) J. Bragg