


1 LOCATION OF WATER WELL: County: Brown Fraction: NW 1/4 NE 1/4 Section Number: 11 Township Number: 2-3-S Range Number: R 18 EW

Distance and direction from nearest town or city street address of well if located within city?
2 1/2 mi E. of Robinson coop Elev.

2 WATER WELL OWNER: Rural Route 1 Box 138 DENNIS TIETJENS - OWNER
 RR#, Address, Box #: Robinson, KS. 66532
 City, State, ZIP Code: Robinson, KS. 66532
 Board of Agriculture, Division of Water Resources
 Application Number:

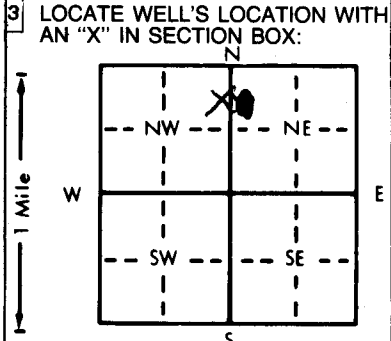

4 DEPTH OF COMPLETED WELL: 52 ft. ELEVATION: 980
 Depth(s) Groundwater Encountered 1. 31 ft. 2. _____ ft. 3. _____ ft.
 WELL'S STATIC WATER LEVEL: 22 ft. below land surface measured on 9-30-91
 Pump test data: Well water was 31 ft. after 3 hours pumping 10 gpm
 Est. Yield 9 gpm: Well water was 32 ft. after 5 hours pumping 10 gpm
 Bore Hole Diameter: 54 in. to 20 ft., and 42 in. to 52 ft.
 WELL WATER TO BE USED AS:
 1 Domestic 3 Feedlot 6 Oil field water supply 9 Dewatering 12 Other (Specify below)
 2 Irrigation 4 Industrial 7 Lawn and garden only 10 Observation well
 Was a chemical/bacteriological sample submitted to Department? Yes _____ No If yes, mo/day/yr sample was submitted _____
 Water Well Disinfected? Yes No _____

5 TYPE OF BLANK CASING USED:
 1 Steel 3 RMP (SR) 5 Wrought iron 8 Concrete tile CASING JOINTS: Glued Clamped _____
 2 PVC 4 ABS 6 Asbestos-Cement 9 Other (specify below) _____ Welded _____
 7 Fiberglass _____ Threaded _____
 Blank casing diameter _____ in. to _____ ft., Dia _____ in. to _____ ft., Dia _____ in. to _____ ft.
 Casing height above land surface: 24 in., weight 320 lbs./ft. Wall thickness or gauge No. 3
 TYPE OF SCREEN OR PERFORATION MATERIAL:
 1 Steel 3 Stainless steel 5 Fiberglass 8 RMP (SR) 10 Asbestos-cement
 2 Brass 4 Galvanized steel 6 Concrete tile 9 ABS 11 Other (specify) _____
 2 None used (open hole)
 SCREEN OR PERFORATION OPENINGS ARE:
 1 Continuous slot 3 Mill slot 5 Gauzed wrapped 8 Saw cut 11 None (open hole)
 2 Louvered shutter 4 Key punched 6 Wire wrapped 9 Drilled holes
 7 Torch cut 10 Other (specify) _____
 SCREEN-PERFORATED INTERVALS: From N/A ft. to N/A ft., From _____ ft. to _____ ft.
 GRAVEL PACK INTERVALS: From _____ ft. to _____ ft., From _____ ft. to _____ ft.

6 GROUT MATERIAL: 1 Neat cement 2 Cement grout 3 Bentonite 4 Other _____
 Grout Intervals: From 0 ft. to 20 ft., From _____ ft. to _____ ft., From _____ ft. to _____ ft.
 What is the nearest source of possible contamination:
 1 Septic tank 4 Lateral lines 7 Pit privy 10 Livestock pens 14 Abandoned water well
 2 Sewer lines 5 Cess pool 8 Sewage lagoon 11 Fuel storage 15 Oil well/Gas well
 3 Watertight sewer lines 6 Seepage pit 9 Feedyard 12 Fertilizer storage 16 Other (specify below) _____
 13 Insecticide storage _____
 Direction from well? _____ How many feet? 900'

FROM	TO	LITHOLOGIC LOG	FROM	TO	LITHOLOGIC LOG
0	2	BLACK TOP SOIL			
2	13	BROWN WIND BLOWN			
13	22	YELLOW CLAY			
22	31	COARSE BROWN SAND & GRAVEL - VERY PRODUCTIVE			
31	52	HARD BLUE CLAY			
	52	BOTTOM - BLUE CLAY			

7 CONTRACTOR'S OR LANDOWNER'S CERTIFICATION: This water well was (1) constructed, (2) reconstructed, or (3) plugged under my jurisdiction and was completed on (mo/day/year) 9-30-91 and this record is true to the best of my knowledge and belief. Kansas Water Well Contractor's License No. 320 This Water Well Record was completed on (mo/day/yr) 10-28-91 under the business name of POPPLEWELL WELL BORING by (signature) Jerry Popplewell

INSTRUCTIONS: Use typewriter or ball point pen, PLEASE PRESS FIRMLY and PRINT clearly. Please fill in blanks, underline or circle the correct answers. Send top three copies to Kansas Department of Health and Environment, Division of Environment, Environmental Geology Section, Topeka, KS 66620. Send one to WATER WELL OWNER and retain one for your records.