


1 LOCATION OF WATER WELL: Fraction SW 1/4 of SW 1/4 SW 1/4 Section Number 15 Township Number T 2 S Range Number R 18 EW
 County: BROWN

Distance and direction from nearest town or city street address of well if located within city?
4 mi NE of Robinson, KS
 2 WATER WELL OWNER: Steven L. Korthanke
 RR#, St. Address, Box #: Rt 1 Box 101
 City, State, ZIP Code: Robinson, KS 66532
 Board of Agriculture, Division of Water Resources
 Application Number:

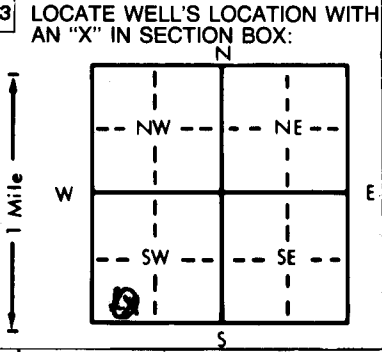

4 DEPTH OF COMPLETED WELL: 87 ft. ELEVATION X 1050
 Depth(s) Groundwater Encountered 1. 72 ft. 2. . ft. 3. . ft.
 WELL'S STATIC WATER LEVEL 42 ft. below land surface measured on mo/day/yr 8-29-89
 Pump test data: Well water was 61 ft. after 2 hours pumping 0 gpm
 Est. Yield 2 gpm: Well water was . ft. after . hours pumping . gpm
 Bore Hole Diameter: 54 in. to 20 ft., and 42 in. to 87 ft.
 WELL WATER TO BE USED AS:
 1 Domestic 3 Feedlot 6 Oil field water supply 9 Dewatering 12 Other (Specify below)
 2 Irrigation 4 Industrial 7 Lawn and garden only 10 Monitoring well
 Was a chemical/bacteriological sample submitted to Department? Yes X No .; If yes, mo/day/yr sample was submitted 8-29-89
 Water Well Disinfected? Yes X No

5 TYPE OF BLANK CASING USED:
 1 Steel 3 RMP (SR) 5 Wrought iron 8 Concrete tile CASING JOINTS: Glued . . . Clamped . . .
 2 PVC 4 ABS 6 Asbestos-Cement 9 Other (specify below) Welded . . .
 Blank casing diameter 36 in. to 87 ft., Dia . in. to . ft., Dia . in. to . ft.
 Casing height above land surface 30 in., weight 320 lbs./ft. Wall thickness or gauge No. 3"
 TYPE OF SCREEN OR PERFORATION MATERIAL:
 1 Steel 3 Stainless steel 5 Fiberglass 8 RMP (SR) 10 Asbestos-cement
 2 Brass 4 Galvanized steel 6 Concrete tile 9 ABS 12 None used (open hole)
 SCREEN OR PERFORATION OPENINGS ARE:
 1 Continuous slot 3 Mill slot 5 Gauzed wrapped 8 Saw cut 1 None (open hole)
 2 Louvered shutter 4 Key punched 6 Wire wrapped 9 Drilled holes
 7 Torch cut 10 Other (specify) . . .
 SCREEN-PERFORATED INTERVALS: From . ft. to . ft., From . ft. to . ft., From . ft. to . ft.
 GRAVEL PACK INTERVALS: From . ft. to . ft., From . ft. to . ft., From . ft. to . ft.

6 GROUT MATERIAL: Neat cement 2 Cement grout 3 Bentonite 4 Other . . .
 Grout Intervals: From 0 ft. to 20 ft., From . ft. to . ft., From . ft. to . ft.
 What is the nearest source of possible contamination:
 1 Septic tank 4 Lateral lines 7 Pit privy 10 Livestock pens 14 Abandoned water well
 2 Sewer lines 5 Cess pool 8 Sewage lagoon 11 Fuel storage 15 Oil well/Gas well
 3 Watertight sewer lines 6 Seepage pit 9 Feedyard 12 Fertilizer storage 16 Other (specify below)
 13 Insecticide storage
 Direction from well? EAST How many feet? 400'

FROM	TO	LITHOLOGIC LOG	FROM	TO	PLUGGING INTERVALS
0	43	BROWN WIND BLOWN			
43	54	YELLOW CLAY			
54	72	HARD YELLOW CLAY WITH ROCKS MIXED IN			
72	81	YELLOW-BROWN SAND - COARSE PRODUCES WATER			
81	87	BLUE CLAY			
	87	BOTTOM - BLUE CLAY			

7 CONTRACTOR'S OR LANDOWNER'S CERTIFICATION: This water well was (1) constructed (2) reconstructed, or (3) plugged under my jurisdiction and was completed on (mo/day/year) 8-29-89 and this record is true to the best of my knowledge and belief. Kansas Water Well Contractor's License No. 320 This Water Well Record was completed on (mo/day/yr) 9-29-89 under the business name of POPPLEWELL WELL BORING by (signature) Jerry Popplewell