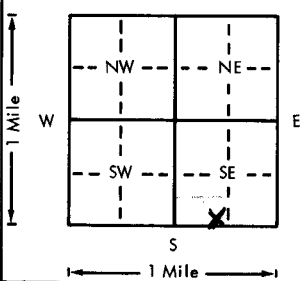


USE TYPEWRITER OR BALL
POINT PEN-PRESS FIRMLY,
PRINT CLEARLY.

WATER WELL RECORD
KSA 82a-1201-1215

Kansas Department of Health and
Environment-Division of Environment
(Water well Contractors)
Topeka, Kansas 66620

DDC

1. Location of well:		County <u>Brown</u>	Fraction <u>SE 1/4 Sec 15</u>	Section number <u>15</u>	Township number <u>T 2 S</u>	Range number <u>R 18 E</u>
2. Distance and direction from nearest town or city: <u>8 E 1 N</u>		3. Owner of well: <u>Robert Bruning</u>		R.R. or street: <u>RR</u>		
Street address of well location if in city: <u>Hiawatha, Ks</u>		City, state, zip code: <u>Robinson, Ks. 66532</u>				
4. Locate with "X" in section below:		Sketch map:		6. Bore hole dia. <u>8</u> in. Completion date <u>6-3-77</u> Well depth <u>100</u> ft.		
				7. Cable tool <input checked="" type="checkbox"/> Rotary <input type="checkbox"/> Driven <input type="checkbox"/> Dug <input type="checkbox"/> Hollow rod <input type="checkbox"/> Jetted <input type="checkbox"/> Bored <input type="checkbox"/> Reverse rotary		
5. Type and color of material		From		To		8. Use: <input checked="" type="checkbox"/> Domestic <input type="checkbox"/> Public supply <input type="checkbox"/> Industry <input type="checkbox"/> Irrigation <input type="checkbox"/> Air conditioning <input type="checkbox"/> Stock <input type="checkbox"/> Lawn <input type="checkbox"/> Oil field water <input type="checkbox"/> Other
<u>Top Soil</u>		<u>0</u>		<u>2</u>		9. Casing: Material <u>Pvc</u> Height <u>Above</u> or below Threaded <input type="checkbox"/> Welded <input type="checkbox"/> Surface <u>24</u> in. RMP <u>PVC</u> Weight <u>2.74</u> lbs./ft. Dia. <u>5</u> in. to <u>100</u> ft. depth Wall Thickness: inches or Dia. <u>5</u> in. to <u>100</u> ft. depth Gauge No. <u>258</u>
<u>Tan Silty Clay</u>		<u>2</u>		<u>8</u>		10. Screen: Manufacturer's name <u>Pumped</u> Type <u>Pvc</u> Dia. <u>5</u> in. Slot/gauze <u>0.20</u> Length <u>20</u> Set between <u>65</u> ft. and <u>85</u> ft. ft. and <u>85</u> ft. Gravel pack? <input checked="" type="checkbox"/> Size range of material <u>0.20/0.80</u>
<u>Lt. Gray Silty Clay</u>		<u>8</u>		<u>13</u>		11. Static water level: <u>50</u> ft. below land surface Date <u>6-3-77</u> mo./day/yr.
<u>Brown Clay</u>		<u>13</u>		<u>35</u>		12. Pumping level below land surfaces: <u>1 1/2</u> test ft. after <u> </u> hrs. pumping <u> </u> g.p.m. ft. after <u> </u> hrs. pumping <u> </u> g.p.m. Estimated maximum yield <u>11</u> g.p.m.
<u>Lt. Gray Clay</u>		<u>35</u>		<u>64</u>		13. Water sample submitted: <u> </u> mo./day/yr. <u> </u> Yes <input checked="" type="checkbox"/> No <u> </u> Date <u> </u>
<u>Yellowish-Brown Clay</u>		<u>64</u>		<u>66</u>		14. Well head completion: <u>Top Casing</u> <u> </u> Pitless adapter <u> </u> inches above grade
<u>Yellowish-Brown Coarse Sand</u>		<u>66</u>		<u>70</u>		15. Well grouted? <u>Yes</u> With: <input checked="" type="checkbox"/> Neat cement <u> </u> Bentonite <u> </u> Concrete <u> </u> Depth: From <u>5</u> ft. to <u>15</u> ft.
<u>Brown Sandy Clay</u>		<u>70</u>		<u>72</u>		16. Nearest source of possible contamination: <u>Feed</u> ft. <u>100</u> Direction <u>North</u> Type <u>Lot</u> Well disinfected upon completion? <input checked="" type="checkbox"/> Yes <u> </u> No <u> </u>
<u>Brown Fine Sand</u>		<u>72</u>		<u>80</u>		17. Pump: <input checked="" type="checkbox"/> Not installed Manufacturer's name <u> </u> Model number <u> </u> HP <u> </u> Volts <u> </u> Length of drop pipe <u> </u> ft. capacity <u> </u> g.p.m. Type: <u> </u> Submersible <u> </u> Turbine <u> </u> Jet <u> </u> Reciprocating <u> </u> Centrifugal <u> </u> Other
<u>Brown Coarse Sand</u>		<u>80</u>		<u>83</u>		20. Water well contractor's certification: This well was drilled under my jurisdiction and this report is true to the best of my knowledge and belief. <u>STADER DALE CO INC 182</u> Business name <u>RTI HOLTON, KS</u> License No. <u> </u> Address <u> </u> Signed <u>Dale Ashm</u> Date <u>6-6-77</u> Authorized representative
<u>Gray Clay</u>		<u>83</u>		<u>100</u>		
(Use a second sheet if needed)						
18. Elevation: <u>1070</u>		19. Remarks: <u>owner will pour cement slab around well.</u>				
Topography: <input checked="" type="checkbox"/> Hill <u> </u> Slope <u> </u> Upland <u> </u> Valley						

Forward the white, blue and pink copies to the Department of Health and Environment

Form WWC-5