


1 LOCATION OF WATER WELL: Fraction ^{NW} NE 1/4 NE 1/4 NW 1/4 Section Number 27 Township Number T 2 S Range Number R 18E

Distance and direction from nearest town or city street address of well if located within city? 2 1/2 N - 1 1/4 E. of Robinson

2 WATER WELL OWNER: Andy Derrick
 RR#, St. Address, Box #: RT. 1 Board of Agriculture, Division of Water Resources
 City, State, ZIP Code: Robinson, Kansas 66532 Application Number:

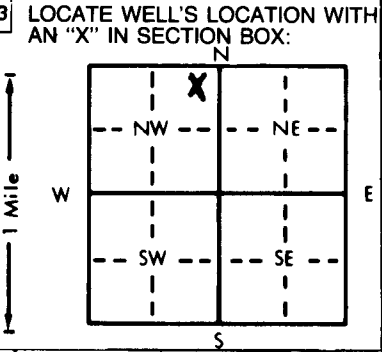

4 DEPTH OF COMPLETED WELL: 50 ft. ELEVATION: 1026 ft.
 Depth(s) Groundwater Encountered 1. 20 ft. 2. ft. 3. ft.
 WELL'S STATIC WATER LEVEL: 7 ft. below land surface measured on mo/day/yr 6-10-82
 Pump test data: Well water was ft. after hours pumping gpm
 Est. Yield 10 gpm: Well water was ft. after hours pumping gpm
 Bore Hole Diameter 10 in. to 50 ft., and in. to ft.
 WELL WATER TO BE USED AS:
 1 Domestic 3 Feedlot 6 Oil field water supply 9 Dewatering 12 Other (Specify below)
 2 Irrigation 4 Industrial 7 Lawn and garden only 10 Observation well
 Was a chemical/bacteriological sample submitted to Department? Yes No ; If yes, mo/day/yr sample was submitted
 Water Well Disinfected? Yes No

5 TYPE OF BLANK CASING USED:
 1 Steel 3 RMP (SR) 5 Wrought iron 8 Concrete tile CASING JOINTS: Glued Clamped
 2 PVC 4 ABS 6 Asbestos-Cement 9 Other (specify below) Welded
 7 Fiberglass Threaded
 Blank casing diameter 5 in. to 15 ft., Dia 5 in. to 50 ft., Dia in. to ft.
 Casing height above land surface 24 in., weight 2.82 lbs./ft. Wall thickness or gauge No. .258

TYPE OF SCREEN OR PERFORATION MATERIAL:
 1 Steel 3 Stainless steel 5 Fiberglass 7 PVC 10 Asbestos-cement
 2 Brass 4 Galvanized steel 6 Concrete tile 8 RMP (SR) 11 Other (specify)
 9 ABS 12 None used (open hole)

SCREEN OR PERFORATION OPENINGS ARE:
 1 Continuous slot 3 Mill slot 5 Gauzed wrapped 8 Saw cut 11 None (open hole)
 2 Louvered shutter 4 Key punched 6 Wire wrapped 9 Drilled holes
 7 Torch cut 10 Other (specify)

SCREEN-PERFORATED INTERVALS: From 15 ft. to 30 ft., From ft. to ft.
 From ft. to ft., From ft. to ft.
 GRAVEL PACK INTERVALS: From 10 ft. to 50 ft., From ft. to ft.
 From ft. to ft., From ft. to ft.

6 GROUT MATERIAL: 1 Neat cement 2 Cement grout 3 Bentonite 4 Other
 Grout Intervals: From 0 ft. to 10 ft., From ft. to ft., From ft. to ft.
 What is the nearest source of possible contamination:
 1 Septic tank 4 Lateral lines 7 Pit privy 10 Livestock pens 14 Abandoned water well
 2 Sewer lines 5 Cess pool 8 Sewage lagoon 11 Fuel storage 15 Oil well/Gas well
 3 Watertight sewer lines 6 Seepage pit 9 Feedyard 12 Fertilizer storage 16 Other (specify below)
 13 Insecticide storage
 Direction from well? E How many feet? 380

FROM	TO	LITHOLOGIC LOG	FROM	TO	LITHOLOGIC LOG
0	6	TOP SOIL			
6	18	CLAY - BROWN			
18	26	SOFT-LOOSE CLAY - BROWN			
26	37	CLAY - BROWN			
37	44	SHALE - GREY			
44	46	LIMESTONE			
46	50	SHALE - GREY			

7 CONTRACTOR'S OR LANDOWNER'S CERTIFICATION: This water well was (1) constructed, (2) reconstructed, or (3) plugged under my jurisdiction and was completed on (mo/day/year) 6-10-82 and this record is true to the best of my knowledge and belief. Kansas Water Well Contractor's License No. 183 This Water Well Record was completed on (mo/day/yr) 7-1-82 under the business name of Strader Drilling Co., Inc. by (signature) Dale Ashren

INSTRUCTIONS: Use typewriter or ball point pen, PLEASE PRESS FIRMLY and PRINT clearly. Please fill in blanks, underline or circle the correct answers. Send top three copies to Kansas Department of Health and Environment, Division of Environment, Environmental Geology Section, Topeka, KS 66620. Send one to WATER WELL OWNER and retain one for your records.