

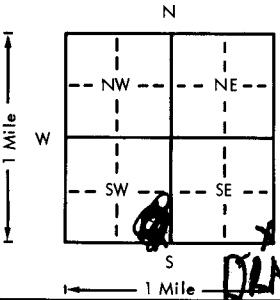
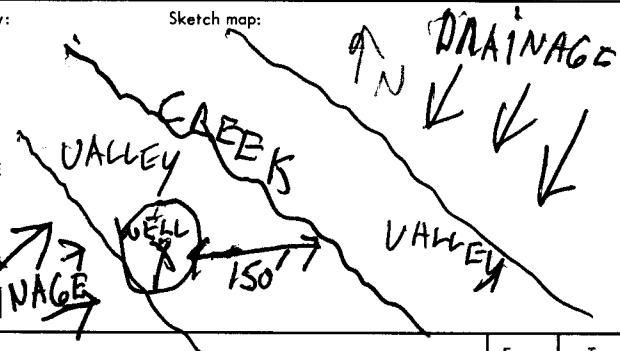
66

1/30

USE TYPEWRITER OR BALL POINT PEN-PRESS FIRMLY, PRINT CLEARLY.

WATER WELL RECORD  
KSA 82a-1201-1215

Kansas Department of Health and Environment-Division of Environment  
(Water well Contractors)  
Topeka, Kansas 66620

1. Location of well:		County <b>Brown</b>	Fraction <b>SE 1/4 SE 1/4 SE 1/4</b>	Section number <b>32</b>	Township number <b>T 2 S R 18</b>	Range number <b>EW</b>
2. Distance and direction from nearest town or city: <b>1 1/2 miles north west of Robinson, Kansas</b>			3. Owner of well: <b>LeRoy Merkel</b> R.R. or street: <b>R.R. I</b> City, state, zip code: <b>Robinson, KS 66532</b>			
4. Locate with "X" in section below:		Sketch map:			6. Bore hole dia. <b>36</b> in. Completion date <b>5/30/78</b> Well depth <b>39</b> ft. Bore hole is <b>42</b> " tall	
					7. Cable tool <input type="checkbox"/> Rotary <input type="checkbox"/> Driven <input type="checkbox"/> Dug <input type="checkbox"/> Hollow rod <input type="checkbox"/> Jetted <input checked="" type="checkbox"/> Bored <input type="checkbox"/> Reverse rotary	
5. Type and color of material		From	To	8. Use: Domestic <input type="checkbox"/> Public supply <input type="checkbox"/> Industry <input type="checkbox"/> Irrigation <input type="checkbox"/> Air conditioning <input checked="" type="checkbox"/> Stock <input type="checkbox"/> Lawn <input type="checkbox"/> Oil field water <input type="checkbox"/> Other <input type="checkbox"/>		
Black topsoil		0	5	9. Casing: Material <b>concrete</b> Height Above or below Threaded <input type="checkbox"/> Welded <input type="checkbox"/> Surface <b>40</b> in. RMP <input type="checkbox"/> PVC <input type="checkbox"/> Weight <b>200</b> lbs./ft. Dia. <b>30</b> in. to <b>39</b> ft. depth Wall Thickness: inches or Dia. <input type="checkbox"/> in. to <input type="checkbox"/> ft. depth gage No. <b>2</b> "		
Black silty wash-in dirt		5	14	10. Screen: Manufacturer's name _____ Type <b>NONE</b> Dia. _____ Slot/gauze _____ Length _____ Set between _____ ft. and _____ ft. _____ ft. and _____ ft. Gravel pack? _____ Size range of material _____		
Brownish yellow silty clay		14	27	11. Static water level: _____ mo./day/yr. <b>18</b> ft. below land surface Date <b>5/29/78</b>		
Large gravel - egg size - very productive		27	32	12. Pumping level below land surfaces: <b>22</b> ft. after <b>1</b> hrs. pumping <b>30</b> g.p.m. <b>28</b> ft. after <b>3</b> hrs. pumping <b>20</b> g.p.m. Estimated maximum yield <b>4 1/2</b> g.p.m.		
Soft shale, gets harder as it gets deeper near limestone at 39ft.		32	39	13. Water sample submitted: _____ mo./day/yr. Yes <input checked="" type="checkbox"/> No <input type="checkbox"/> Date _____		
				14. Well head completion: <input type="checkbox"/> Pitless adapter _____ Inches above grade		
				15. Well grouted? <input checked="" type="checkbox"/> With: <input checked="" type="checkbox"/> Neat cement <input type="checkbox"/> Bentonite <input type="checkbox"/> Concrete Depth: From <b>0</b> ft. to <b>11</b> ft.		
				16. Nearest source of possible contamination: ft. <b>150</b> Direction <b>EAST</b> Type <b>creek</b> Well disinfected upon completion? <input checked="" type="checkbox"/> Yes <input type="checkbox"/> No		
				17. Pump: <input checked="" type="checkbox"/> Not installed Manufacturer's name _____ Model number _____ HP _____ Volts _____ Length of drop pipe _____ ft. capacity _____ g.p.m. Type: <input type="checkbox"/> Submersible <input type="checkbox"/> Turbine <input type="checkbox"/> Jet <input type="checkbox"/> Reciprocating <input type="checkbox"/> Centrifugal <input type="checkbox"/> Other		
				18. Elevation: <b>996</b> Topography: <input type="checkbox"/> Hill <input type="checkbox"/> Slope <input type="checkbox"/> Upland <input checked="" type="checkbox"/> Valley		
				19. Remarks: <b>Concrete slab and vent will be installed by customer. He knows and understands this is a regulation.</b>  <i>LeRoy Merkel</i>		
				20. Water well contractor's certification: This well was drilled under my jurisdiction and this report is true to the best of my knowledge and belief. <b>POPPLEWELL WELL BORING 320</b> Business name _____ License No. _____ Address <b>Amity, MO 64422</b> Signed <i>Jerry Popplewell</i> Date <b>6/15/78</b> Authorized Representative		

Forward the white, blue and pink copies to the Department of Health and Environment

Form WWC-5

BR = 964      2 = 978

1-2-180-32-1/4 SESESE