


1 LOCATION OF WATER WELL: NE 1/4 Fraction Section Number 36 Township Number T 2 S Range Number R 18 EW
 County: Brown

Distance and direction from nearest town or city street address of well if located within city?
2 1/2 E - 1/2 N of Robinson KS

2 WATER WELL OWNER: Three Pines Trust
 RR#, St. Address, Box #: Box 134 Board of Agriculture, Division of Water Resources
 City, State, ZIP Code: Robinson KANS Application Number:

3 LOCATE WELL'S LOCATION WITH AN "X" IN SECTION BOX: 37 4 DEPTH OF COMPLETED WELL: 72 ft. ELEVATION: ≈ 1110

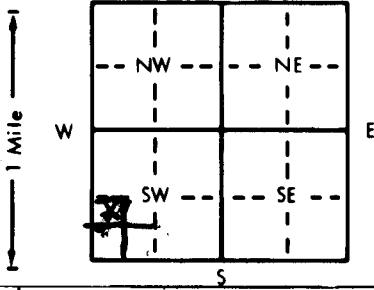

Depth(s) Groundwater Encountered 1. 61 ft. 2. ft. 3. ft.
 WELL'S STATIC WATER LEVEL . . . 56 ft. below land surface measured on mo/day/yr 12-7-89
 Pump test data: Well water was . . . 63 ft. after . . . 2 hours pumping . . . 10 gpm
 Est. Yield . . . 4 gpm: Well water was . . . ft. after . . . hours pumping . . . gpm
 Bore Hole Diameter. 54 in. to . . . 20 ft., and . . . 42 in. to 72 ft.
 WELL WATER TO BE USED AS:
 1 Domestic 3 Feedlot 6 Oil field water supply 9 Dewatering 12 Other (Specify below)
 2 Irrigation 4 Industrial 7 Lawn and garden only 10 Monitoring well General Farm USE
 Was a chemical/bacteriological sample submitted to Department? Yes . . . No X; If yes, mo/day/yr sample was submitted

5 TYPE OF BLANK CASING USED: 5 Wrought iron 6 Concrete tile CASING JOINTS: Glued Clamped
 1 Steel 3 RMP (SR) 6 Asbestos-Cement 9 Other (specify below) Welded
 2 PVC 4 ABS 7 Fiberglass Threaded

Blank casing diameter . . . 36 in. to 72 ft., Dia . . . in. to . . . ft., Dia . . . in. to . . . ft.
 Casing height above land surface . . . 30 in., weight . . . 320 lbs./ft. Wall thickness or gauge No.

TYPE OF SCREEN OR PERFORATION MATERIAL:
 1 Steel 3 Stainless steel 5 Fiberglass 8 RMP (SR) 11 Other (specify)
 2 Brass 4 Galvanized steel 6 Concrete tile 9 ABS 12 None used (open hole)

SCREEN OR PERFORATION OPENINGS ARE:
 1 Continuous slot 3 Mill slot 5 Gauzed wrapped 8 Saw cut 11 None (open hole)
 2 Louvered shutter 4 Key punched 6 Wire wrapped 9 Drilled holes

SCREEN-PERFORATED INTERVALS: From ft. to ft., From ft. to ft.
 GRAVEL PACK INTERVALS: From ft. to ft., From ft. to ft.

6 GROUT MATERIAL: 1 Neat cement 2 Cement grout 3 Bentonite 4 Other
 Grout Intervals: From . . . 0 ft. to 20 ft., From ft. to ft., From ft. to ft.

What is the nearest source of possible contamination:
 1 Septic tank 4 Lateral lines 7 Pit privy 10 Livestock pens 14 Abandoned water well
 2 Sewer lines 5 Cess pool 8 Sewage lagoon 11 Fuel storage 15 Oil well/Gas well
 3 Watertight sewer lines 6 Seepage pit 9 Feedyard 12 Fertilizer storage 16 Other (specify below)
 13 Insecticide storage

Direction from well? SOUTH How many feet? 200

FROM	TO	LITHOLOGIC LOG	FROM	TO	PLUGGING INTERVALS
0	23	Brown windblown			
23	31	Yellow clay			
31	44	Yellow clay			
44	61	Same - chert rock thruout			
61	69	Coarse brown sand			
69	72	Blue clay			

7 CONTRACTOR'S OR LANDOWNER'S CERTIFICATION: This water well was 1 constructed (2) reconstructed, or (3) plugged under my jurisdiction and was completed on (mo/day/year) 12-7-89 and this record is true to the best of my knowledge and belief. Kansas Water Well Contractor's License No. 320 This Water Well Record was completed on (mo/day/yr) 1-2-90 under the business name of POPPLEWELL WELL BORING by (signature) Jerry Popplewell