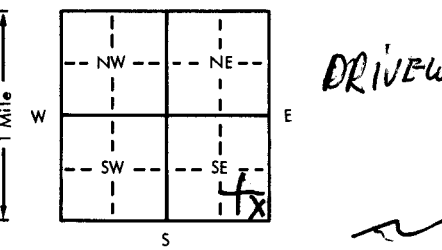


1. Location of well: County <b>Doniphan</b> Fraction <b>SE 1/4 SE 1/4 SE 1/4</b> Section number <b>3</b> Township number <b>2</b> Range number <b>19</b>		3. Owner of well: <b>Shelby Gilmore</b> R.R. or street: City, state, zip code: <b>Highland, Kansas 66035</b>	
2. Distance and direction from nearest town or city: <b>2 1/2 miles north of Highland, KS</b> Street address of well location if in city:		4. Bore hole dia. <b>34</b> in. Completion date <b>3/12/76</b> Well depth <b>51</b> ft. Bore Hole is <b>42</b> ft.	
4. Locate with "X" in section below: 		6. Use: <input checked="" type="checkbox"/> Domestic <input type="checkbox"/> Public supply <input type="checkbox"/> Industry <input type="checkbox"/> Irrigation <input type="checkbox"/> Air conditioning <input type="checkbox"/> Stock <input type="checkbox"/> Lawn <input type="checkbox"/> Oil field water <input type="checkbox"/> Other	
5. Type and color of material		9. Casing: Material <b>concrete</b> Height <b>24</b> ft. or below Threaded <input type="checkbox"/> Welded <input type="checkbox"/> Surface <b>200</b> in. RMP <b>30</b> PVC <input type="checkbox"/> Weight <b>200</b> lbs./ft. Dia. <b>30</b> in. to <b>51</b> ft. depth Wall Thickness: inches or Dia. <b>30</b> in. to <b>51</b> ft. depth gage No. <b>2 in.</b>	
Black topsoil		10. Screen: Manufacturer's name <b>None</b> Type <b>None</b> Dia. <b>None</b> Slot/gauze <b>None</b> Length <b>None</b> Set between <b>None</b> ft. and <b>None</b> ft. Gravel pack? <input type="checkbox"/> Size range of material <b>None</b>	
Dry - dark brown windblown		11. Static water level: <b>31</b> ft. below land surface Date <b>3/12/76</b>	
Light brown windblown		12. Pumping level below land surfaces: ft. after <b>44</b> hrs. pumping <b>6</b> g.p.m. ft. after <b>21</b> hrs. pumping <b>6</b> g.p.m. Estimated maximum yield <b>6</b> g.p.m.	
Grayish windblown with brown streaks		13. Water sample submitted: <b>X</b> Yes <input type="checkbox"/> No Date <b>3/12/76</b>	
Sandy brown windblown that produces water		14. Well head completion: <input type="checkbox"/> Pitless adapter <input type="checkbox"/> Inches above grade	
Hard yellow clay		15. Well grouted? <input checked="" type="checkbox"/> X With: <input checked="" type="checkbox"/> Neat cement <input type="checkbox"/> Bentonite <input type="checkbox"/> Concrete Depth: From <b>0</b> ft. to <b>11</b> ft.	
Blue clay - hard		16. Nearest source of possible contamination: ft. <b>400</b> Direction <b>south</b> Type <b>ditch</b> Well disinfected upon completion? <input checked="" type="checkbox"/> Yes <input type="checkbox"/> No	
Blue shale - gradually gets harder		17. Pump: <input checked="" type="checkbox"/> X Not installed Manufacturer's name <b>None</b> Model number <b>None</b> HP <b>None</b> Volts <b>None</b> Length of drop pipe <b>None</b> ft. capacity <b>None</b> g.p.m. Type: <input type="checkbox"/> Submersible <input type="checkbox"/> Turbine <input type="checkbox"/> Jet <input type="checkbox"/> Reciprocating <input type="checkbox"/> Centrifugal <input type="checkbox"/> Other	
18. Elevation: <b>970</b> Topography: <input checked="" type="checkbox"/> Hill <input type="checkbox"/> Slope <input type="checkbox"/> Upland <input type="checkbox"/> Valley		19. Remarks: <b>Concrete slab and vent will be installed by customer. He knows and understands this is a regulation.</b> <b>Shelby Gilmore</b>	
20. Water well contractor's certification: This well was drilled under my jurisdiction and this report is true to the best of my knowledge and belief. <b>POPPLEWELL WELL BORING 320</b> Business name <b>AMITY</b> MO <b>64422</b> License No. Address <b>Popplewell</b> Signed <b>Popplewell</b> Date <b>3/12/76</b> Authorized representative			

$$BR = 922 \quad \nabla = 926$$