


USE TYPEWRITER OR BALL POINT PEN-PRESS FIRMLY, PRINT CLEARLY.

WATER WELL RECORD  
KSA 82a-1201-1215

Kansas Department of Health and Environment-Division of Environment (Water well Contractors) Topeka, Kansas 66620

1. Location of well:	County <b>DONIPHAN</b>	Fraction <b>NW 1/4 SW 1/4 SW 1/4</b>	Section number <b>5</b>	Township number <b>T 2 S R 19</b>	Range number <b>(E) W</b>
----------------------	---------------------------	---	----------------------------	--------------------------------------	------------------------------

2. Distance and direction from nearest town or city: <b>2 MILES WEST AND 3 1/2 MILES NORTH OF HIGHLAND, KANSAS</b>	3. Owner of well: <b>ARNOLD SHONYO</b>
Street address of well location if in city:	R.R. or street: <b>HIGHLAND, KANSAS 66035</b>
	City, state, zip code:

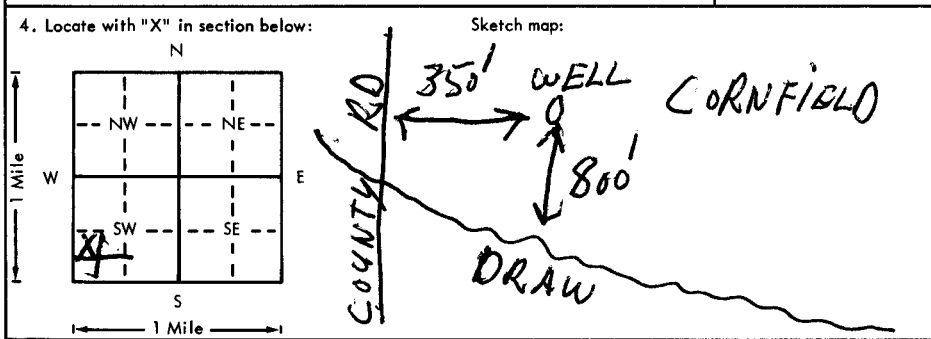

6. Bore hole dia. <u>34</u> in. Completion date <u>10-2-75</u> Well depth <u>34</u> ft. <b>FIRST 11' BORE HOLE 42</b>
7. Cable tool <input type="checkbox"/> Rotary <input type="checkbox"/> Driven <input type="checkbox"/> Dug <input type="checkbox"/> Hollow rod <input type="checkbox"/> Jetted <input checked="" type="checkbox"/> Bored <input type="checkbox"/> Reverse rotary
8. Use: Domestic <input type="checkbox"/> Public supply <input type="checkbox"/> Industry <input type="checkbox"/> Irrigation <input type="checkbox"/> Air conditioning <input checked="" type="checkbox"/> Stock <input type="checkbox"/> Lawn <input type="checkbox"/> Oil field water <input type="checkbox"/> Other <input type="checkbox"/>
9. Casing: Material <u>CONCRETE</u> Height: <u>Above</u> or below Threaded <input type="checkbox"/> Welded <input type="checkbox"/> Surface <input type="checkbox"/> Dia. <u>30</u> in. RMP <input type="checkbox"/> PVC <input type="checkbox"/> Weight <u>200</u> lbs./ft. Dia. <u>30</u> in. to <u>34</u> ft. depth Wall Thickness: inches or Dia. <input type="checkbox"/> in. to <input type="checkbox"/> ft. depth gage No. <u>2 in.</u>

5. Type and color of material	From	To
BLACK TOPSOIL	0	2 1/2
BROWNISH WINDBLOWN DIRT	2 1/2	6
BROWN - YELLOW WINDBLOWN - VERY FINE	6	15
DRY COARSE BROWN SAND	15	17
COARSE BROWN SAND - VERY WET AND UNSTABLE	17	21
YELLOW CLAY - FAIRLY HARD	21	28
HARD BLUE CLAY	28	34
(Use a second sheet if needed)		

10. Screen: Manufacturer's name _____ Type _____ Dia. _____ Slot/gauze _____ Length _____ Set between _____ ft. and _____ ft. _____ ft. and _____ ft. Gravel pack? _____ Size range of material _____
11. Static water level: _____ mo./day/yr. <u>17</u> ft. below land surface Date <u>10-2-75</u>
12. Pumping level below land surfaces: <u>20</u> ft. after <u>1</u> hrs. pumping <u>8</u> g.p.m. <u>22</u> ft. after <u>4</u> hrs. pumping <u>8</u> g.p.m. Estimated maximum yield <u>12</u> g.p.m.
13. Water sample submitted: _____ mo./day/yr. Yes <input checked="" type="checkbox"/> No <input type="checkbox"/> Date _____
14. Well head completion: _____ Pitless adapter _____ Inches above grade
15. Well grouted? <input checked="" type="checkbox"/> With: <input checked="" type="checkbox"/> Neat cement <input type="checkbox"/> Bentonite <input type="checkbox"/> Concrete Depth: From <u>0</u> ft. to <u>11</u> ft.
16. Nearest source of possible contamination: ft. <u>800</u> Direction <u>SOUTH</u> Type <u>CREEK</u> Well disinfected upon completion? <input checked="" type="checkbox"/> Yes <input type="checkbox"/> No
17. Pump: <input checked="" type="checkbox"/> Not installed Manufacturer's name _____ Model number _____ HP _____ Volts _____ Length of drop pipe _____ ft. capacity _____ g.p.m. Type: <input type="checkbox"/> Submersible <input type="checkbox"/> Turbine <input type="checkbox"/> Jet <input type="checkbox"/> Reciprocating <input type="checkbox"/> Centrifugal <input type="checkbox"/> Other

18. Elevation: <u>928</u>	19. Remarks: <b>CONCRETE SLAB AND VENT WILL BE INSTALLED BY CUSTOMER. HE KNOWS AND UNDERSTANDS THIS IS A REGULATION.</b>
Topography: <input type="checkbox"/> Hill <input checked="" type="checkbox"/> Slope <input type="checkbox"/> Upland <input type="checkbox"/> Valley	<i>Arnold Shonyo</i>

20. Water well contractor's certification: This well was drilled under my jurisdiction and this report is true to the best of my knowledge and belief. <b>POPPLEWELL WELL BORING 320</b> Business name _____ License No. _____ Address <b>AMITY, MISSOURI 64422</b> Signed <i>Jerry Popplewell</i> Date <u>10/16/75</u> Authorized Representative
---

T-2 190 W-5 NASH SW 1/4 1/4 1/4