


USE TYPEWRITER OR BALL POINT PEN—PRESS FIRMLY, PRINT CLEARLY.

WATER WELL RECORD
KSA 82a-1201-1215

Kansas Department of Health and Environment—Division of Environment (Water well Contractors) Topeka, Kansas 66620

1. Location of well: County **DONIPHAN** Fraction **SE 1/4 SE 1/4 SW 1/4** Section number **10** Township number **T 2 S** Range number **R 19** **(E)W**

2. Distance and direction from nearest town or city: **2 miles north, and 1/2 mile west of Highland, Kansas**
Street address of well location if in city:
3. Owner of well: **Robert Twombly**
R.R. or street: **RR 1**
City, state, zip code: **Highland, Kansas 66035**

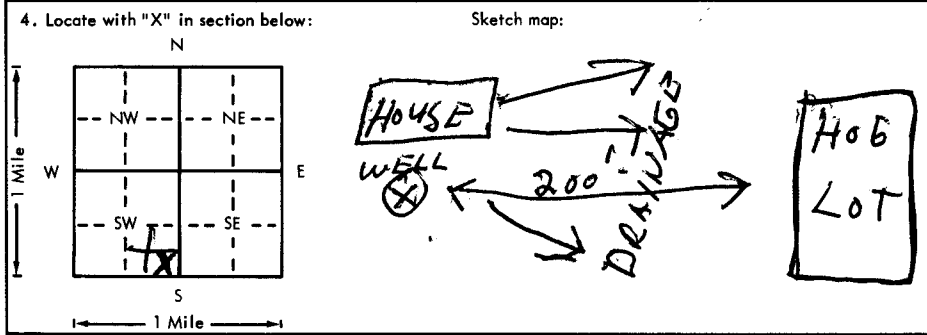

6. Bore hole dia. **34** in. Completion date **9/26/75**
Well depth **54** ft. **First 14' Bore Hole** 4
7. Cable tool Rotary Driven Aug
 Hollow rod Jetted Bored Reverse rotary
8. Use: Domestic Public supply Industry
 Irrigation Air conditioning Stock
 Lawn Oil field water Other
9. Casing: Material **Concrete** Height: **Above** or below
Threaded Welded Surface **18** in.
RMP PVC Weight **200** lbs./ft.
Dia. **30** in. to **54** ft. depth; Wall Thickness: inches or
Dia. in. to ft. depth; gage No. **2 in.**

5. Type and color of material	From	To
Black Topsoil	0	1
Yellow Fine Windblown	1	7
Yellow Wind Blown, Fairly Hard And Dry	7	19
Brownish Clay - Hard	19	29
Sandy Clay - Brown in Color	29	34
Coarse Sand and Small Gravel	34	38
Wet and Brown in Color		
Hard Yellow Clay	38	44
Gray Shale Gradually Gets Harder Toward the	44	54
Bottom		

10. Screen: Manufacturer's name _____
Type _____ Dia. _____
Slot/gauze _____ Length _____
Set between _____ ft. and _____ ft.
_____ ft. and _____ ft.
Gravel pack? _____ Size range of material _____
11. Static water level: _____ mo./day/yr.
36 ft. below land surface Date **9/26/75**
12. Pumping level below land surfaces:
42 ft. after **2** hrs. pumping **9** g.p.m.
49 ft. after **3** hrs. pumping **9** g.p.m.
Estimated maximum yield _____ g.p.m.
13. Water sample submitted: _____ mo./day/yr.
Yes No Date _____
14. Well head completion:
 Pitless adapter **18** inches above grade
15. Well grouted?
With: Neat cement Bentonite Concrete
Depth: From **3** ft. to **14** ft.
16. Nearest source of possible contamination:
ft. **200** Direction **East** Type **Hog Lot**
Well disinfected upon completion? Yes No
17. Pump: Not installed
Manufacturer's name _____
Model number _____ HP _____ Volts _____
Length of drop pipe _____ ft. capacity _____ g.p.m.
Type:
 Submersible Turbine
 Jet Reciprocating
 Centrifugal Other

18. Elevation: **980'**
Topography: Hill Slope Upland Valley
19. Remarks: **Concrete Slab and Vent will be installed by customer. He knows and understands this is a regulation.**
x Robert Twombly

20. Water well contractor's certification:
This well was drilled under my jurisdiction and this report is true to the best of my knowledge and belief.
Popplewell Well Boring 320
Business name **AMITY, MISSOURI** License No. _____
Address _____
Signed **Jerry Popplewell** Date **10/16/75**
Authorized Representative

T-2 120 W 10 SE SE SW 1/4 1/4