USE TYPEWRITER OR BALL POINT PEN-PRESS FIRMLY, PRINT CLEARLY.

WATER WELL RECORD
KSA 82a-1201-1215

Kansas Department of Health and Environment-Division of Environment
(Water well Contractors)
Topeka, Kansas 66620

1. Location of well:	County	Fraction	Section number	Township number	Range number
	Doniphan	NW SW ~~1/4~~ ~~1/4~~ SE 1/4	13	T 2 (S)	R 19 (E) W

2. Distance and direction from nearest town or city: Two miles east and one mile north of Highland, Kansas.
Street address of well location if in city:

3. Owner of well: Rudy Collins
R.R. or street: P. O. Box 23
City, state, zip code: Highland, KS 66035

4. Locate with "X" in section below:

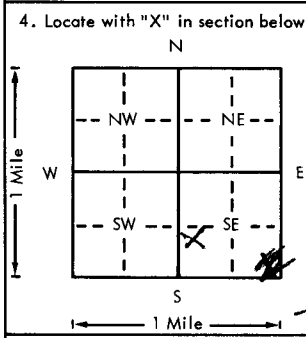

Sketch map:

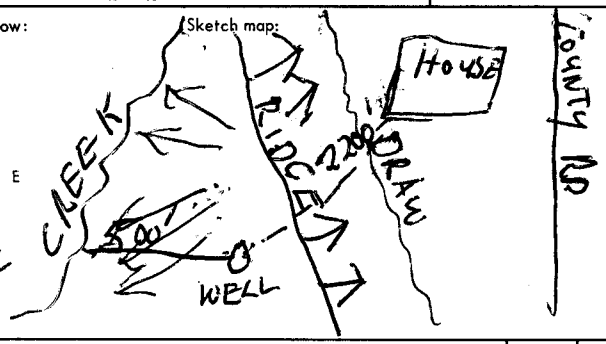

6. Bore hole dia. 34 in. Completion date 4/17/79
Well depth 30 ft. Bore hole is 42" to 1

7. __ Cable tool __ Rotary __ Driven __ Dug
__ Hollow rod __ Jetted X Bored __ Reverse rotary

8. Use: X Domestic __ Public supply __ Industry
__ Irrigation __ Air conditioning __ Stock
__ Lawn __ Oil field water __ Other

9. Casing: Material concrete Height: (Above) or below
Threaded ___ Welded ___ Surface 30 in.
RMP ___ PVC ___ Weight 200 lbs./ft.
Dia. 30 in. to 30 ft. depth Wall Thickness: inches or
Dia. ___ in. to ___ ft. depth gage No. 2"

5. Type and color of material	From	To
Brown silty topsoil	0	2
Hard yellow - brown	2	14
wind-blown dirt		
Sandy, soft windblown	14	23
with some gravel, produces water		
Blue-gray shale, gradually gets harder	23	29
Limestone bedrock	30	
(Use a second sheet if needed)		

10. Screen: Manufacturer's name
Type ___ Dia. ___
Slot/gauze ___ Length ___
Set between ___ ft. and ___ ft.
___ ft. and ___ ft.
Gravel pack? ___ Size range of material

11. Static water level: mo./day/yr.
14 ft. below land surface Date 4/16/79

12. Pumping level below land surfaces:
4 ft. after 2 hrs. pumping 6 g.p.m.
4 ft. after 2 hrs. pumping 6 g.p.m.
Estimated maximum yield 5 g.p.m.

13. Water sample submitted: mo./day/yr.
__ Yes X No Date

14. Well head completion:
__ Pitless adapter ___ Inches above grade

15. Well grouted? X
With: X Neat cement __ Bentonite __ Concrete
Depth: From 0 ft. to 11 ft.

16. Nearest source of possible contamination:
ft. 500 Direction west Type creek
Well disinfected upon completion? X Yes __ No

17. Pump: X Not installed
Manufacturer's name
Model number ___ HP ___ Volts ___
Length of drop pipe ___ ft. capacity ___ g.p.m.
Type:
__ Submersible __ Turbine
__ Jet __ Reciprocating
__ Centrifugal __ Other

T 2 R 19 E W
Sec 13
1/4 SE SE SE 1/4

18. Elevation: 928 msl
Topography:
__ Hill
X Slope
__ Upland
__ Valley

19. Remarks: Concrete slab and vent will be installed by customer. He knows and understands this is a regulation.

X Rudy Collins

20. Water well contractor's certification:
This well was drilled under my jurisdiction and this report is true to the best of my knowledge and belief.
POPPLEWELL WELL BORING 320
Business name License No.
Address AMITY, MO 64422
Signed Jerry Popplewell Date 5/8/79
Authorized representative

Forward the white, blue and pink copies to the Department of Health and Environment

Form WWC-5