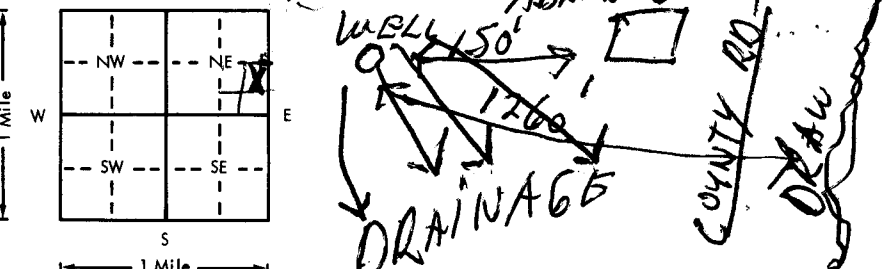


1. Location of well:		County <b>DONIPHAN</b>	Fraction <b>NE 1/4 SE 1/4 NE 1/4</b>	Section number <b>18</b>	Township number <b>T 2</b>	Range number <b>(S) R 19 (E) W</b>
2. Distance and direction from nearest town or city: <b>TWO MILES WEST AND 1 1/2 MILES NORTH OF HIGHLAND, KANSAS</b> Street address of well location if in city:				3. Owner of well: <b>VINCENT FALK</b> R.R. or street: <b>RR</b> City, state, zip code: <b>LEONA, KANSAS 66448</b>		
4. Locate with "X" in section below:		Sketch map:				6. Bore hole dia. <u>34</u> in. Completion date <u>10/8/75</u> Well depth <u>57</u> ft. <b>FIRST 11' BORE HOLE</b> 42
						7. <u>  </u> Cable tool <u>  </u> Rotary <u>  </u> Driven <u>  </u> Dug <u>  </u> Hollow rod <u>  </u> Jetted <input checked="" type="checkbox"/> Bored <u>  </u> Reverse rotary
5. Type and color of material		From	To	8. Use: <u>  </u> Domestic <u>  </u> Public supply <u>  </u> Industry <u>  </u> Irrigation <u>  </u> Air conditioning <input checked="" type="checkbox"/> Stock <u>  </u> Lawn <u>  </u> Oil field water <u>  </u> Other		
BLACK TOPSOIL		0	1 1/2	9. Casing: Material <u>CONCRETE</u> Height: <u>  </u> Above or below Threaded <u>  </u> Welded <u>  </u> Surface <u>28</u> in. RMP <u>  </u> PVC <u>  </u> Weight <u>200</u> lbs./ft.		
BROWNISH YELLOW WINDBLOWN		1 1/2	13	Dia. <u>30</u> in. to <u>57</u> ft. depth Wall Thickness: inches or Dia. <u>  </u> in. to <u>  </u> ft. depth gage No. <u>2 in.</u>		
DARK BROWN WINDBLOWN		13	16	10. Screen: Manufacturer's name <u>  </u> Type <u>  </u> Dia. <u>  </u> Slot/gauze <u>  </u> Length <u>  </u> Set between <u>  </u> ft. and <u>  </u> ft. <u>  </u> ft. and <u>  </u> ft. Gravel pack? <u>  </u> Size range of material <u>  </u>		
SEMI-HARD YELLOW CLAY		16	25	11. Static water level: <u>  </u> mo./day/yr. <u>32</u> ft. below land surface Date <u>10/7/75</u>		
YELLOW CLAY WITH SOME DRY COARSE SAND - <u>  </u>		25	31	12. Pumping level below land surfaces: <u>39</u> ft. after <u>3</u> hrs. pumping <u>9</u> g.p.m. <u>43</u> ft. after <u>5</u> hrs. pumping <u>9</u> g.p.m. Estimated maximum yield <u>14</u> g.p.m.		
IN IT				13. Water sample submitted: <u>  </u> mo./day/yr. <u>  </u> Yes <input checked="" type="checkbox"/> No Date <u>  </u>		
DRY COARSE SAND - YELLOW		31	34	14. Well head completion: <u>  </u> Pitless adapter <u>  </u> Inches above grade		
WET BROWNISH SAND - COARSE		34	42	15. Well grouted? <input checked="" type="checkbox"/> <u>  </u> With: <input checked="" type="checkbox"/> Neat cement <u>  </u> Bentonite <u>  </u> Concrete Depth: From <u>0</u> ft. to <u>11</u> ft.		
COARSE YELLOW SAND VERY WET		42	53	16. Nearest source of possible contamination: ft. <u>1260</u> Direction <u>EAST</u> Type <u>DRAW</u> Well disinfected upon completion? <input checked="" type="checkbox"/> Yes <u>  </u> No		
VERY COARSE SAND AND WET		53	55	17. Pump: <input checked="" type="checkbox"/> Not installed Manufacturer's name <u>  </u> Model number <u>  </u> HP <u>  </u> Volts <u>  </u> Length of drop pipe <u>  </u> ft. capacity <u>  </u> g.p.m. Type: <u>  </u> Submersible <u>  </u> Turbine <u>  </u> Jet <u>  </u> Reciprocating <u>  </u> Centrifugal <u>  </u> Other		
GRAVEL-SOME GRAVEL-EGG SIZE				18. Elevation: <u>1000</u> Topography: <u>  </u> Hill <input checked="" type="checkbox"/> Slope <u>  </u> Upland <u>  </u> Valley		
BLUE CLAY MEDIUM HARDNESS		55	57	19. Remarks: <b>CONCRETE SLAB AND VENT WILL BE INSTALLED BY CUSTOMER. HE KNOWS AND UNDERSTANDS THIS IS A REGULATION.</b> <i>Vincent Falk</i>		
				20. Water well contractor's certification: This well was drilled under my jurisdiction and this report is true to the best of my knowledge and belief. <b>POPPLER WELL BORING 320</b> Business name <b>AMITY, MO 64422</b> License No. <u>  </u> Address <u>  </u> Signed <u>Vincent Falk</u> Date <u>10/29/75</u> Authorized representative		