

County: Washington Fraction SW SE Sec. 26 T. 2 S R. 2 (E)W

CORRECTION(S) TO WATER WELL COMPLETION RECORD (WWC-5)

(to rectify lacking or incorrect information)

Owner: Endicott Clay Products Co.

Location was listed as:

Location changed to:

Section-Township-Range: 26-2-2E

26-2S-2E

Fraction (1/4 1/4 1/4): None Given

SW SE

Other changes: Initial statements: _____

Changed to: _____

Comments: _____

Verification method: Legal description, position on plat map,
and mapping tool & aerial photos on KGS website.

initials: DRK date: 8/27/2015


Submitted by: Kansas Geological Survey, Data Resources Library, 1930 Constant Ave., Lawrence, KS 66047-3726

to: Kansas Dept of Health & Environment, Bureau of Water, 1000 SW Jackson, Suite 420, Topeka, KS 66612-1367.

1	LOCATION OF WATER WELL:	Fraction	Section Number	Township Number	Range Number
	County: <u>Washington</u>	$\frac{1}{4}$ $\frac{1}{4}$ $\frac{1}{4}$	<u>26</u>	<u>2</u>	<u>2</u> EW

Distance and direction from nearest town or city street address of well if located within city?

2	WATER WELL OWNER: <u>Endicott Clay Products Co.</u>	Board of Agriculture, Division of Water Resources
	RR #, St. Address, Box #: <u>57120 - 703 R.O.</u>	Application Number:
	City, State, ZIP Code: <u>Endicott, NE 68350</u>	

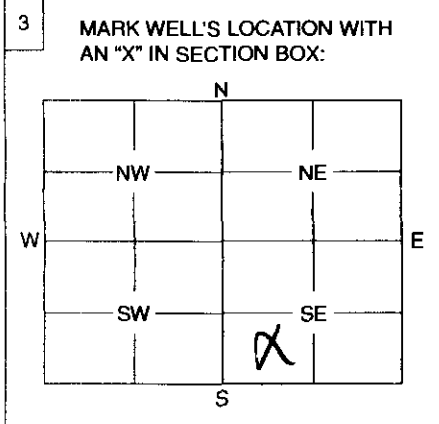

4	DEPTH OF WELL <u>35</u> ft.												
	WELL'S STATIC WATER LEVEL <u>26</u> ft.												
	WELL WAS USED AS:												
	<table border="0"> <tr> <td>1 Domestic</td> <td>5 Public Water Supply</td> <td>9 Dewatering</td> </tr> <tr> <td>2 Irrigation</td> <td>6 Oil Field Water Supply</td> <td><input checked="" type="checkbox"/> 10 Monitoring Well</td> </tr> <tr> <td>3 Feedlot</td> <td>7 Domestic (Lawn & Garden)</td> <td>11 Injection Well</td> </tr> <tr> <td>4 Industrial</td> <td>8 Air Conditioning</td> <td>12 Other</td> </tr> </table>	1 Domestic	5 Public Water Supply	9 Dewatering	2 Irrigation	6 Oil Field Water Supply	<input checked="" type="checkbox"/> 10 Monitoring Well	3 Feedlot	7 Domestic (Lawn & Garden)	11 Injection Well	4 Industrial	8 Air Conditioning	12 Other
1 Domestic	5 Public Water Supply	9 Dewatering											
2 Irrigation	6 Oil Field Water Supply	<input checked="" type="checkbox"/> 10 Monitoring Well											
3 Feedlot	7 Domestic (Lawn & Garden)	11 Injection Well											
4 Industrial	8 Air Conditioning	12 Other											
	Was a chemical / bacteriological sample submitted to Department? Yes No <input checked="" type="checkbox"/>												
	If yes, mo/day/yr sample was submitted												
	Water Well Disinfected: Yes <input checked="" type="checkbox"/> No												

5	TYPE OF BLANK CASING USED:										
	<table border="0"> <tr> <td>1 Steel</td> <td>3 RMP (SR)</td> <td>5 Wrought</td> <td>7 Fiberglass</td> <td>9 Other (Specify below) <u>Sandstone Rock</u></td> </tr> <tr> <td>2 PVC</td> <td>4 ABS</td> <td>6 Asbestos-Cement</td> <td>8 Concrete Tile</td> <td></td> </tr> </table>	1 Steel	3 RMP (SR)	5 Wrought	7 Fiberglass	9 Other (Specify below) <u>Sandstone Rock</u>	2 PVC	4 ABS	6 Asbestos-Cement	8 Concrete Tile	
1 Steel	3 RMP (SR)	5 Wrought	7 Fiberglass	9 Other (Specify below) <u>Sandstone Rock</u>							
2 PVC	4 ABS	6 Asbestos-Cement	8 Concrete Tile								
	Blank casing diameter <u>36</u> in. Was casing pulled? Yes No <input checked="" type="checkbox"/>										
	Casing height above or <u>below</u> land surface <u>48'</u> in. If yes, how much										

6	GROUT PLUG MATERIAL: 1 Neat cement <input checked="" type="checkbox"/> 2 Cement grout	3 Bentonite	4 Other																				
	Grout Plug Intervals: From <u>6</u> ft. to <u>4</u> ft., From ft. to ft., From to ft.																						
	What is the nearest source of possible contamination:																						
	<table border="0"> <tr> <td>1 Septic tank</td> <td>6 Seepage pit</td> <td>11 Fuel storage</td> <td>16 Other (specify below)</td> </tr> <tr> <td>2 Sewer lines</td> <td>7 Pit privy</td> <td><input checked="" type="checkbox"/> 12 Fertilizer storage</td> <td></td> </tr> <tr> <td>3 Watertight sewer lines</td> <td>8 Sewage lagoon</td> <td>13 Insecticide storage</td> <td></td> </tr> <tr> <td>4 Lateral lines</td> <td>9 Feedyard</td> <td>14 Abandoned water well</td> <td></td> </tr> <tr> <td>5 Cess pool</td> <td>10 Livestock pens</td> <td>15 Oil well/Gas well</td> <td></td> </tr> </table>	1 Septic tank	6 Seepage pit	11 Fuel storage	16 Other (specify below)	2 Sewer lines	7 Pit privy	<input checked="" type="checkbox"/> 12 Fertilizer storage		3 Watertight sewer lines	8 Sewage lagoon	13 Insecticide storage		4 Lateral lines	9 Feedyard	14 Abandoned water well		5 Cess pool	10 Livestock pens	15 Oil well/Gas well			
1 Septic tank	6 Seepage pit	11 Fuel storage	16 Other (specify below)																				
2 Sewer lines	7 Pit privy	<input checked="" type="checkbox"/> 12 Fertilizer storage																					
3 Watertight sewer lines	8 Sewage lagoon	13 Insecticide storage																					
4 Lateral lines	9 Feedyard	14 Abandoned water well																					
5 Cess pool	10 Livestock pens	15 Oil well/Gas well																					
	Direction from well? <u>North</u> How many feet? <u>500</u>																						

FROM	TO	PLUGGING MATERIALS
<u>35'</u>	<u>6'</u>	<u>Sand</u>
<u>6'</u>	<u>4'</u>	<u>Cement Grout</u>
<u>4'</u>	<u>0'</u>	<u>Clay + Top soil</u>

7	CONTRACTOR'S OF UNDERWRITER'S CERTIFICATION: This water well was plugged under my jurisdiction and was completed on (mo/day/year) <u>12-29-14</u> and this record is true to the best of my knowledge and belief. Kansas Water Well Contractor's License No. This Water Well Record was completed on (mo/day/year)
	under the business name of <u>Endicott Clay Products Co.</u>
	by (signature) <u>Ron M. Slater</u>