


WATER WELL RECORD Form WWC-5 KSA 82a-1212

1 LOCATION OF WATER WELL: Sedgwick FRACTION: SW 1/4 NW 1/4 NW 1/4 SECTION NUMBER: 7 TOWNSHIP NUMBER: T 29 S RANGE NUMBER: R 2E E/W

Distance and direction from nearest town or city street address of well if located within city? 820 E. Madison Derby, Kansas

2 WATER WELL OWNER: DERBY MIDDLE SCHOOL RR#ST. ADDRESS,BOX #: 820 E. Madison CITY, STATE: Derby, Kansas Board of Agriculture, Division of Water Resource ZIP CODE: 67037 Application Number:

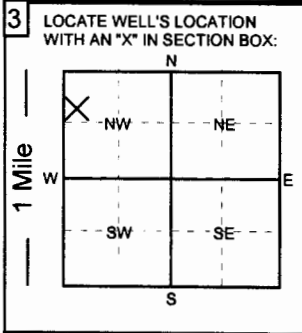

4 DEPTH OF PLUGGED WELL: 109 ft. ELEVATION: WELL'S STATIC WATER LEVEL: 18 FT. BELOW LAND SURFACE MEASURED ON 1/24/19 Pump test data: Well water was ft. after hours of pumping @ gpm

5 TYPE OF CASING USED: 1. Steel 2. PVC 3. RPM (SR) 4. ABS 5. Wrought Iron 6. Asbestos-Cement 7. Fiberglass 8. Concrete tile 9. Other (Specify below) CASING JOINTS: Glued Threaded Welded Clamped

6 GROUT MATERIALS: 1. Neat cement 2. Cement Grout 3. Bentonite Other bentonite hole plug Grout Intervals: From 3 ft. to 23 ft.

LITHOLOGIC LOG table with columns for From, To, and description of layers (compact d clay, bentonite hole plug, chlorinated gravel).

7 Contractor's or Landowner's Certification: This water well was 1. constructed 2. reconstructed or 3. plugged under my jurisdiction and was completed on (mo/day/year) 1/24/19 and this record is true to the best of my knowledge and belief.