

WATER WELL RECORD Form WWC-5


Division of Water Resources App. No.

Well ID

Original Record Correction Change in Well Use

1 LOCATION OF WATER WELL: County: WASHINGTON Fraction 1/4 SE 1/4 NW 1/4 NW 1/4 Section Number 21 Township Number T 2 S Range Number R 2 E W

2 WELL OWNER: Last Name: HAUSCHEL First: TOM Street or Rural Address where well is located (if unknown, distance and direction from nearest town or intersection): NORTH OF MORROWVILLE ON HWY 15 TO 21 ROAD. WEST 21/2 MILES.

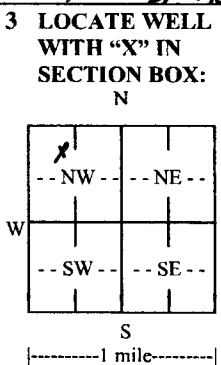

3 LOCATE WELL WITH 'X' IN SECTION BOX: N, W, E, S. 4 DEPTH OF COMPLETED WELL: 45 ft. WELL'S STATIC WATER LEVEL: 9/26/2019 below land surface, measured on (mo-day-yr).

5 Latitude: 39 52.191N Longitude: 97 12.932W Horizontal Datum: NAD 83 Source for Latitude/Longitude: GPS (unit make/model: MAGELLAN EXPLORIST)

6 Elevation: Ground Level TOC Source: Land Survey GPS Topographic Map Other

7 WELL WATER TO BE USED AS: 1. Domestic: Household, Lawn & Garden, Livestock. 2. Irrigation. 3. Feedlot. 4. Industrial. 5. Public Water Supply. 6. Dewatering. 7. Aquifer Recharge. 8. Monitoring. 9. Environmental Remediation. 10. Oil Field Water Supply. 11. Test Hole. 12. Geothermal. 13. Other.

Was a chemical/bacteriological sample submitted to KDHE? No If yes, date sample was submitted: Water well disinfected? No

8 TYPE OF CASING USED: PVC CASING JOINTS: Glued Casing diameter 5 in. to 25 ft., Diameter 18 in. to 2.8 ft., Diameter 2.8 in. to 285 ft. Casing height above land surface 18 in. Weight 2.8 lbs./ft. Wall thickness or gauge No. 285

TYPE OF SCREEN OR PERFORATION MATERIAL: PVC SCREEN OR PERFORATION OPENINGS ARE: Mill Slot SCREEN-PERFORATED INTERVALS: From 25 ft. to 45 ft. GRAVEL PACK INTERVALS: From 24 ft. to 45 ft.

9 GROUT MATERIAL: Bentonite Grout Intervals: From 4 ft. to 24 ft.

Nearest source of possible contamination: Lateral Lines, Pit Privy, Livestock Pens, Insecticide Storage, Sewer Lines, Cess Pool, Sewage Lagoon, Fuel Storage, Abandoned Water Well, Watertight Sewer Lines, Seepage Pit, Feedyard, Fertilizer Storage, Oil Well/Gas Well

Table with columns: 10 FROM, TO, LITHOLOGIC LOG, FROM, TO, LITHO. LOG (cont.) or PLUGGING INTERVALS. Rows: 0-24 LIGHT BROWN SANDY CLAY, 24-42 YELLOW & TAN SILTY CLAY, 42-80 GRAY SOAPSTONE & HARD ROCK LAYERS.

11 CONTRACTOR'S OR LANDOWNER'S CERTIFICATION: This water well was constructed, reconstructed, or plugged under my jurisdiction and was completed on (mo-day-year) 9/26/2019 and this record is true to the best of my knowledge and belief. Kansas Water Well Contractor's License No. 518 This Water Well Record was completed on (mo-day-year) 10/5/2019 under the business name of BLUE VALLEY DRILLING INC. Signature

Mail 1 white copy along with a fee of \$5.00 for each constructed well to: Kansas Department of Health and Environment, Bureau of Water, GWTS Section, 1000 SW Jackson St., Suite 420, Topeka, Kansas 66612-1367. Mail one to Water Well Owner and retain one for your records. Telephone 785-296-5524. Visit us at http://www.kdheks.gov/waterwell/index.html KSA 82a-1212 Revised 7/10/2015