


USE TYPEWRITER OR BALL POINT PEN-PRESS FIRMLY, PRINT CLEARLY.

WATER WELL RECORD
KSA 82a-1201-1215

Kansas Department of Health and Environment-Division of Environment (Water well Contractors) Topeka, Kansas 66620

1. Location of well: County WASHINGTON Fraction SE 1/4 SW 1/4 SW 1/4 NW 1/4 Section number 5 Township number T 2 S R 2 E Range number 2

2. Distance and direction from nearest town or city: 3 E - 3 1/2 N 3. Owner of well: MELVIN WURM
Street address of well location if in city: HADDAM R.R. or street: RR #2
City, state, zip code: HADDAM, KANSAS 66944

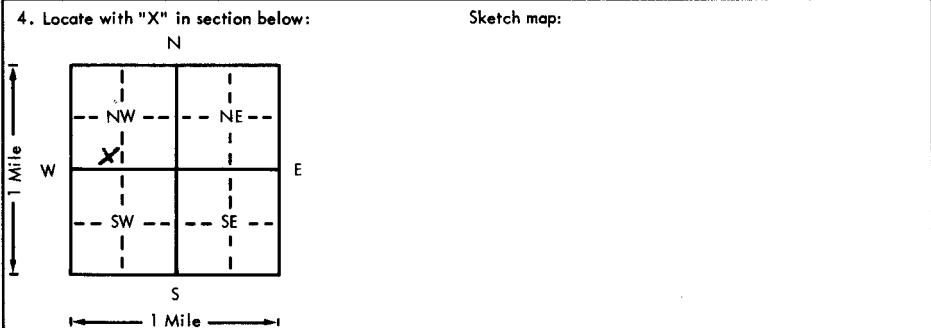

6. Bore hole dia. 5 in. Completion date 2/27/74
Well depth 75 ft.
7. Cable tool Rotary Driven Dug
 Hollow rod Jetted Bored Reverse rotary
8. Use: Domestic Public supply Industry
 Irrigation Air conditioning Stock
 Lawn Oil field water Other
9. Casing: Material PVC Height Above or below
Threaded Welded Surface 18 in.
RMP PVC Weight 3 lbs./ft.
Dia. 5 in. to 75 ft. depth Wall Thickness: inches or
Dia. in. to ft. depth gage No. 160#

5. Type and color of material	From	To
<u>TOPSOIL</u>	<u>0</u>	<u>3</u>
<u>BROWN CLAY</u>	<u>3</u>	<u>9</u>
<u>BROWN CLAY w/LIMESTONE</u>	<u>9</u>	<u>12</u>
<u>LIMESTONE</u>	<u>12</u>	<u>13</u>
<u>BROWN CLAY</u>	<u>13</u>	<u>26</u>
<u>SAND</u>	<u>26</u>	<u>35</u>
<u>GRAVEL w/ROCK LAYERS</u>	<u>35</u>	<u>72</u>
<u>GRAY CLAY</u>	<u>72</u>	<u>75</u>
<u>STOP</u>	<u>75</u>	

10. Screen: Manufacturer's name GUARANTEED
Type PVC Dia. 5"
Slot gauge 1/16 Length 20'
Set between 75 ft. and ft.
0 ft. and 75 ft.
Gravel pack? YES Size range of material 20 X 4
11. Static water level: 40 ft. below land surface Date 2/27/74 mo./day/yr.
12. Pumping level below land surfaces:
 ft. after hrs. pumping g.p.m.
 ft. after hrs. pumping g.p.m.
Estimated maximum yield 2.5 g.p.m.
13. Water sample submitted: mo./day/yr.
Yes No Date
14. Well head completion:
 Pitless adapter Inches above grade
15. Well grouted? YES
With: Neat cement Bentonite Concrete
Depth: From 0 ft. to 10 ft.
16. Nearest source of possible contamination:
ft. 100 Direction WEST Type SEPTIC
Well disinfected upon completion? Yes No
17. Pump: Not installed
Manufacturer's name
Model number HP Volts
Length of drop pipe ft. capacity g.p.m.
Type:
 Submersible Turbine
 Jet Reciprocating
 Centrifugal Other

18. Elevation: 1450.54
Topography:
 Hill
 Slope
 Upland
 Valley

19. Remarks:

20. Water well contractor's certification:
This well was drilled under my jurisdiction and this report is true to the best of my knowledge and belief.
Business name Geo Cox & Sons Inc 258 License No.
Address CLIFTON, KANS
Signed Dayle Cox Date 2/27/74
Authorized representative

T
R
W
S
Sec
1/4
1/4
1/4
SES WNW