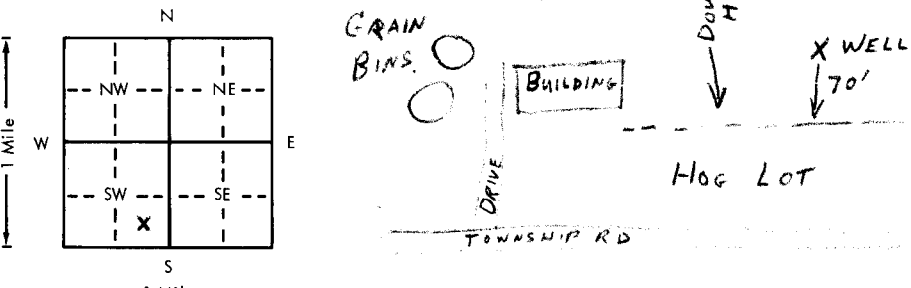


USE TYPEWRITER OR BALL POINT PEN-PRESS FIRMLY, PRINT CLEARLY.

WATER WELL RECORD
KSA 82a-1201-1215

Kansas Department of Health and Environment-Division of Environment (Water well Contractors) Topeka, Kansas 66620

1. Location of well:	County Washington	Fraction SE 1/4 SE 1/4 SW 1/4	Section number 22 12	Township number T 2 S R 2E	Range number E/W		
2. Distance and direction from nearest town or city: 2N-1/2E from Morrowville Street address of well location if in city:			3. Owner of well: Rosenthal Brothers R.R. or street: Route 1 City, state, zip code: Morrowville, KAN 66958				
4. Locate with "X" in section below: 			6. Bore hole dia. 9 in. Completion date 5-10-79 Well depth 80 ft.				
5. Type and color of material			7. Cable tool <input checked="" type="checkbox"/> Rotary <input type="checkbox"/> Driven <input type="checkbox"/> Dug <input type="checkbox"/> Hollow rod <input type="checkbox"/> Jetted <input type="checkbox"/> Bored <input type="checkbox"/> Reverse rotary				
			8. Use: <input type="checkbox"/> Domestic <input type="checkbox"/> Public supply <input type="checkbox"/> Industry <input type="checkbox"/> Irrigation <input type="checkbox"/> Air conditioning <input checked="" type="checkbox"/> Stock <input type="checkbox"/> Lawn <input type="checkbox"/> Oil field water <input type="checkbox"/> Other				
From			9. Casing: Material _____ Height: Above or below Threaded _____ Welded <input checked="" type="checkbox"/> Surface 18 in. RMP _____ PVC <input checked="" type="checkbox"/> Weight _____ lbs./ft. Dia. 5 in. to 80 ft. depth Wall Thickness: inches or Dia. _____ in. to _____ ft. depth gage No. .265				
			10. Screen: Manufacturer's name _____ Type PVC slot Dia. 5" Slot/gauze .020 Length 20' Set between 60 ft. and 80 ft. _____ ft. and _____ ft. Gravel pack? <input checked="" type="checkbox"/> yes Size range of material 47-B				
Clay, brown			0	2	11. Static water level: _____ mo./day/yr. 45 ft. below land surface Date 5-10-79		
Clay, tan & brown			2	8	12. Pumping level below land surfaces: _____ ft. after _____ hrs. pumping _____ g.p.m. _____ ft. after _____ hrs. pumping _____ g.p.m. Estimated maximum yield 25 g.p.m.		
Clay, brown			8	20	13. Water sample submitted: _____ mo./day/yr. <input type="checkbox"/> Yes <input checked="" type="checkbox"/> No Date _____		
Clay, sandy, brown			20	35	14. Well head completion: <input type="checkbox"/> Pitless adapter _____ Inches above grade		
Sand, medium to coarse			35	54	15. Well grouted? <input checked="" type="checkbox"/> yes With: <input type="checkbox"/> Neat cement <input checked="" type="checkbox"/> Bentonite <input type="checkbox"/> Concrete Depth: From 0 ft. to 30 ft.		
Sandstone, fine to medium, yellow (medium cement)			54	82	16. Nearest source of possible contamination: ft. 558 Direction S Type hog lot Well disinfected upon completion? <input checked="" type="checkbox"/> Yes <input type="checkbox"/> No		
					17. Pump: <input checked="" type="checkbox"/> Not installed Manufacturer's name _____ Model number _____ HP _____ Volts _____ Length of drop pipe _____ ft. capacity _____ g.p.m. Type: <input type="checkbox"/> Submersible <input type="checkbox"/> Turbine <input type="checkbox"/> Jet <input type="checkbox"/> Reciprocating <input type="checkbox"/> Centrifugal <input type="checkbox"/> Other		
(Use a second sheet if needed)							
18. Elevation: 7150 7435 Topography: <input type="checkbox"/> Hill <input checked="" type="checkbox"/> Slope <input type="checkbox"/> Upland <input type="checkbox"/> Valley		19. Remarks:		20. Water well contractor's certification: This well was drilled under my jurisdiction and this report is true to the best of my knowledge and belief. Holly Well Drilling, Inc. Business name _____ License No. _____ Address Crete, NEB Signed Nancy L. Holly Date 5/28/79 Authorized representative			

T
R
W
Sec
1/4
1/4
1/4
1/4
SESESW