


1 LOCATION OF WATER WELL: County: Washington Fraction: NW 1/4 NW 1/4 NW 1/4 Section Number: 36 Township Number: T 2 S Range Number: R 2 EW

2 WATER WELL OWNER: Junior Sawyer  
 RR#, St. Address, Box #: Monnowville, Kansas 66958  
 City, State, ZIP Code: Monnowville, Kansas 66958  
 Board of Agriculture, Division of Water Resources  
 Application Number: \_\_\_\_\_

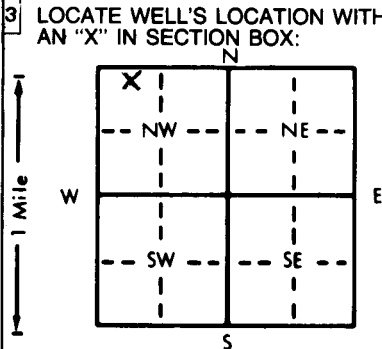

4 DEPTH OF COMPLETED WELL: 110 ft. ELEVATION: unknown  
 Depth(s) Groundwater Encountered 1. 36 ft. 2. 0 ft. 3. 0 ft.  
 WELL'S STATIC WATER LEVEL 36 ft. below land surface measured on mo/day/yr  
 Pump test data: Well water was no test ft. after \_\_\_\_\_ hours pumping \_\_\_\_\_ gpm  
 Est. Yield 10 gpm: Well water was \_\_\_\_\_ ft. after \_\_\_\_\_ hours pumping \_\_\_\_\_ gpm  
 Bore Hole Diameter 10 in. to 110 ft., and \_\_\_\_\_ in. to \_\_\_\_\_ ft.  
 WELL WATER TO BE USED AS:  
 Domestic 3 Feedlot 6 Oil field water supply 9 Dewatering 12 Other (Specify below)  
 2 Irrigation 4 Industrial 7 Lawn and garden only 10 Observation well  
 Was a chemical/bacteriological sample submitted to Department? Yes \_\_\_\_\_ No  If yes, mo/day/yr sample was submitted \_\_\_\_\_  
 Water Well Disinfected? Yes  No \_\_\_\_\_

5 TYPE OF BLANK CASING USED:  
 1 Steel 3 RMP (SR) 5 Wrought iron 8 Concrete tile CASING JOINTS: Glued \_\_\_\_\_ Clamped \_\_\_\_\_  
 2 PVC 4 ABS 6 Asbestos-Cement 9 Other (specify below) Welded \_\_\_\_\_  
 Blank casing diameter 5 in. to 90 ft., Dia \_\_\_\_\_ in. to \_\_\_\_\_ ft., Dia \_\_\_\_\_ in. to \_\_\_\_\_ ft.  
 Casing height above land surface 24 in., weight 2.91 lbs./ft. Wall thickness or gauge No. 265 SDR21  
 TYPE OF SCREEN OR PERFORATION MATERIAL:  
 7 PVC 10 Asbestos-cement  
 1 Steel 3 Stainless steel 5 Fiberglass 8 RMP (SR) 11 Other (specify) \_\_\_\_\_  
 2 Brass 4 Galvanized steel 6 Concrete tile 9 ABS 12 None used (open hole)  
 SCREEN OR PERFORATION OPENINGS ARE:  
 8 Saw cut 11 None (open hole)  
 1 Continuous slot 3 Mill slot 5 Gauzed wrapped 6 Wire wrapped 9 Drilled holes  
 2 Louvered shutter 4 Key punched 7 Torch cut 10 Other (specify) \_\_\_\_\_  
 SCREEN-PERFORATED INTERVALS: From 9.0 ft. to 11.0 ft., From \_\_\_\_\_ ft. to \_\_\_\_\_ ft.  
 From \_\_\_\_\_ ft. to \_\_\_\_\_ ft., From \_\_\_\_\_ ft. to \_\_\_\_\_ ft.  
 GRAVEL PACK INTERVALS: From 7.0 ft. to 11.0 ft., From \_\_\_\_\_ ft. to \_\_\_\_\_ ft.  
 From \_\_\_\_\_ ft. to \_\_\_\_\_ ft., From \_\_\_\_\_ ft. to \_\_\_\_\_ ft.

6 GROUT MATERIAL:  1 Neat cement 2 Cement grout 3 Bentonite 4 Other Clay Backfill  
 Grout intervals: From 10 ft. to 30 ft., From \_\_\_\_\_ ft. to \_\_\_\_\_ ft., From 30 ft. to 70 ft.  
 What is the nearest source of possible contamination:  
 14 Abandoned water well  
 1 Septic tank 4 Lateral lines 7 Pit privy 10 Livestock pens 11 Fuel storage 15 Oil well/Gas well  
 2 Sewer lines 5 Cess pool 8 Sewage lagoon 12 Fertilizer storage 16 Other (specify below)  
 3 Watertight sewer lines 6 Seepage pit 9 Feedyard 13 Insecticide storage  
 Direction from well? East How many feet? 50

FROM	TO	LITHOLOGIC LOG	FROM	TO	LITHOLOGIC LOG
0	20	Clay			
20	35	Clay			
35	37	Sand			
37	40	Clay, little stone			
40	42	Brown clay			
42	55	Brown clay			
55	57	Hard rock			
57	60	Gray clay			
60	75	Gray clay			
75	80	Sandstone			
80	90	Sandstone			

7 CONTRACTOR'S OR LANDOWNER'S CERTIFICATION: This water well was (1) constructed, (2) reconstructed, or (3) plugged under my jurisdiction and was completed on (mo/day/year) 5/22/88 and this record is true to the best of my knowledge and belief. Kansas Water Well Contractor's License No. 480 This Water Well Record was completed on (mo/day/yr) 9/11/88 under the business name of Williams Drilling Co., Inc. by (signature) Ron Williams