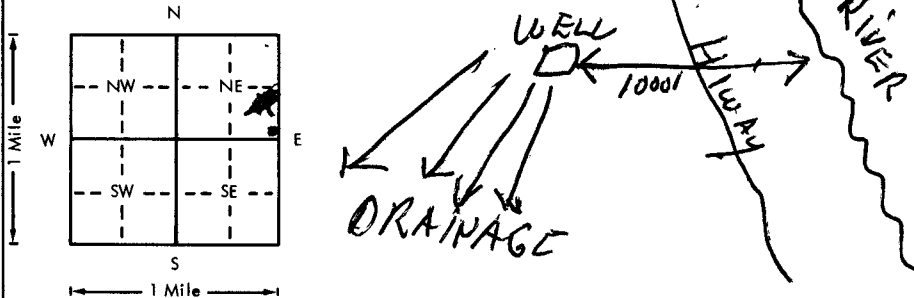


USE TYPEWRITER OR BALL
POINT PEN-PRESS FIRMLY,
PRINT CLEARLY.

WATER WELL RECORD
KSA 82a-1201-1215

Kansas Department of Health and
Environment-Division of Environment
(Water well Contractors)
Topeka, Kansas 66620

1. Location of well:		County DONIPHAN	Fraction SE 1/4 SE 1/4 NE 1/4	Section number 6	Township number T 2 S	Range number R 20 E
2. Distance and direction from nearest town or city: 5 miles north of Sparks, Kansas Street address of well location if in city:			3. Owner of well: Jack Whetstine R.R. or street: City, state, zip code: Highland, Kansas			
4. Locate with "X" in section below:		Sketch map:		6. Bore hole dia. <u>34</u> in. Completion date <u>8/10/76</u> Well depth <u>28</u> ft. Bore hole is <u>42"</u> to 10'		
				7. Cable tool <input type="checkbox"/> Rotary <input type="checkbox"/> Driven <input type="checkbox"/> Dig <input type="checkbox"/> Hollow rod <input type="checkbox"/> Jetted <input checked="" type="checkbox"/> Bored <input type="checkbox"/> Reverse rotary		
5. Type and color of material		From	To	8. Use: <input checked="" type="checkbox"/> Domestic <input type="checkbox"/> Public supply <input type="checkbox"/> Industry <input type="checkbox"/> Irrigation <input type="checkbox"/> Air conditioning <input type="checkbox"/> Stock <input type="checkbox"/> Lawn <input type="checkbox"/> Oil field water <input type="checkbox"/> Other		
Black silty topsoil		0	4 1/2	9. Casing: Material <u>concrete</u> Height: <u>Above</u> or below Threaded <input type="checkbox"/> Welded <input type="checkbox"/> Surface <u>24</u> in. RMP <input type="checkbox"/> PVC <input type="checkbox"/> Weight <u>200</u> lbs./ft. Dia. <u>30</u> in. to <u>28</u> ft. depth Wall Thickness <u>inches</u> or Dia. <u>in.</u> to <u>ft.</u> depth gage No. <u>2"</u>		
Grayish - silty clay		4 1/2	11	10. Screen: Manufacturer's name Type <u>None</u> Dia. Slot/gauze <u>None</u> Length Set between <u>ft.</u> and <u>ft.</u> <u>ft.</u> and <u>ft.</u> Gravel pack? <input type="checkbox"/> Size range of material		
Very soft yellow clay		11	21	11. Static water level: <u>11</u> ft. below land surface Date <u>8/10/76</u> mo./day/yr.		
Gray sand and gravel - very productive		21	26	12. Pumping level below land surfaces: <u>21</u> ft. after <u>2 1/2</u> hrs. pumping <u>18</u> g.p.m. Estimated maximum yield <u>7</u> g.p.m.		
Hard blue clay		26	28	13. Water sample submitted: <u>Yes</u> <input checked="" type="checkbox"/> No Date		
				14. Well head completion: <input type="checkbox"/> Pitless adapter <u>inches</u> above grade		
				15. Well grouted? <input checked="" type="checkbox"/> With: <input checked="" type="checkbox"/> Neat cement <input type="checkbox"/> Bentonite <input type="checkbox"/> Concrete Depth: From <u>0</u> ft. to <u>10</u> ft.		
				16. Nearest source of possible contamination: ft. <u>1000</u> Direction <u>E</u> Type <u>River</u> Well disinfected upon completion? <input checked="" type="checkbox"/> Yes <input type="checkbox"/> No		
				17. Pump: <input checked="" type="checkbox"/> Not installed Manufacturer's name Model number <u>HP</u> <u>Volts</u> Length of drop pipe <u>ft.</u> capacity <u>g.p.m.</u> Type: <input type="checkbox"/> Submersible <input type="checkbox"/> Turbine <input type="checkbox"/> Jet <input type="checkbox"/> Reciprocating <input type="checkbox"/> Centrifugal <input type="checkbox"/> Other		
				18. Elevation: <u>850</u> Topography: <input type="checkbox"/> Hill <input checked="" type="checkbox"/> Slope <input type="checkbox"/> Upland <input type="checkbox"/> Valley		
		(Use a second sheet if needed)		19. Remarks: Concrete slab and vent will be installed by customer. He knows and understands this is regulation. <i>Jack Whetstine</i>		
				20. Water well contractor's certification: This well was drilled under my jurisdiction and this report is true to the best of my knowledge and belief. POPPLEWELL WELL BORING 320 Business name <u>Amity, Missouri</u> License No. <u>64422</u> Address <u>Amity, Missouri</u> Signed <u>Jerry Popplewell</u> Date <u>9/1/76</u> Authorized representative		

Forward the white, blue and pink copies to the Department of Health and Environment

Form WWC-5

BR<822 V=839