USE TYPEWRITER OR BALL POINT PEN-PRESS FIRMLY, PRINT CLEARLY.

T	R	EW	sec 1/4	1/4	1/4	No.			

WATER WELL RECORD
KSA 82a-1201-1215

Kansas State Dept. Of Health
(Water Well Contractors)
Forbes-Bldg. 740
Topeka, Kansas 66620

SW SW NW

1 Location of well:	County	Township name	Fraction	Section number	Town number	Range number
	DONIPHAN	IOWA	NW 1/4	18	2	20 E

Distance and direction from nearest town or city: 2 N - 3 E - 1/2 S

Street address of well location if in city: Highland, Ks

3 Owner of well: Fred Cluck

Address: Highland, KANSAS

Locate with "X" in section below:

Sketch map:

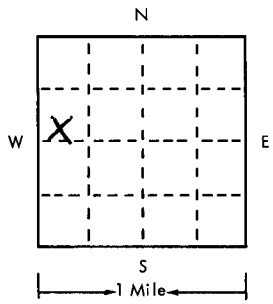

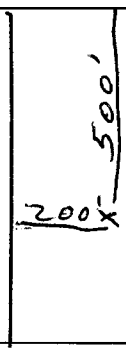

4 Well depth: 40' ft. Date of completion 2-11-75
Well diameter 10 in.

5 ☐ Cable tool ☒ Rotary ☐ Driven ☐ Dug
☐ Hollow rod ☐ Jetted ☐ Bored ☐ Reverse rotary

6 Use: ☒ Domestic ☐ Public supply ☐ Industry
☐ Irrigation ☐ Air conditioning ☐ Commercial
☐ Test well ☐

7 Casing: Material PVC Height: above/below
Threaded ☐ Welded ☐ Surface 24 in.
Diam. Weight 2.33 lbs./ft.
0 in. to 40 ft. depth Drive shoe? ☐ Yes ☒ No
in. to ft. depth

2

Type and color of material	From	To
TOP SOIL	0	5
yellow CLAY	5	30
COURSE SAND	30	40
(use a second sheet if needed)		

8 Screen:
Manufacturer PumpCO
Type PVC Dia. 5
Slot/gauze 60 Length 10
Set between 30 ft. and 40 ft.
Fittings:
Gravel pack ☒ Yes ☐ No Size range of material 1/4 x 1/8

9 Static water level: No measurement
ft. below land surface Date

10 Pumping level below land surfaces: Air Test
ft. after hrs. pumping g.p.m.
ft. after hrs. pumping g.p.m.
Estimated maximum yield 5 g.p.m.

11 Water sample submitted:
☐ Yes ☒ No Date

12 Well head completion:
☒ Pitless adapter 24" ☐ Inches above grade

13 Well grouted? ☒ Yes ☐ No
☒ Neat cement ☐ Bentonite ☐
Depth: From 0 ft. to 10 ft.

14 Nearest source of possible contamination:
ft. 400' Direction North Type SEPTIC TANK
Well disinfected upon completion? ☒ Yes ☐ No

15 Pump: ☒ Not installed
Manufacturer's name
Model number HP Volts
Length of drop pipe ft. capacity g.m.p.
Type:
☐ Submersible ☐ Turbine
☐ Jet ☐ Reciprocating
☐ Certrifugal ☐ Other

16 Remarks: elevation
970'

Topography:
☐ Hill
☒ Slope
☐ Upland
☐ Valley

17 Water well contractor's certification:
This well was drilled under my jurisdiction and this report is true to the best of my knowledge and belief.
Strader Drilling Co. Inc. #182
Business name License No.
Address RR1 - N75 Holton, KANS.
Signed Dale Cashman Date 2-13-75
Authorized representative

Forward the white, blue and pink copies to the Kansas State Dept. Of Health.

Form WWC-5