


USE TYPEWRITER OR BALL POINT PEN - PRESS FIRMLY, PRINT CLEARLY.

WATER WELL RECORD
KSA 82a-1201-1215

Kansas Department of Health and Environment - Division of Environment
(Water well Contractors)
Topeka, Kansas 66620

1. Location of well: County DONIPHAN Fraction SW NE SE Section number 20 Township number T 2 S Range number R 20 EW

2. Distance and direction from nearest town or city: 1/2 mile south of Fanning, Kansas
Street address of well location if in city: 2011
3. Owner of well: Larry Handley
R.R. or street: RR 1
City, state, zip code: Troy, Kansas 66087

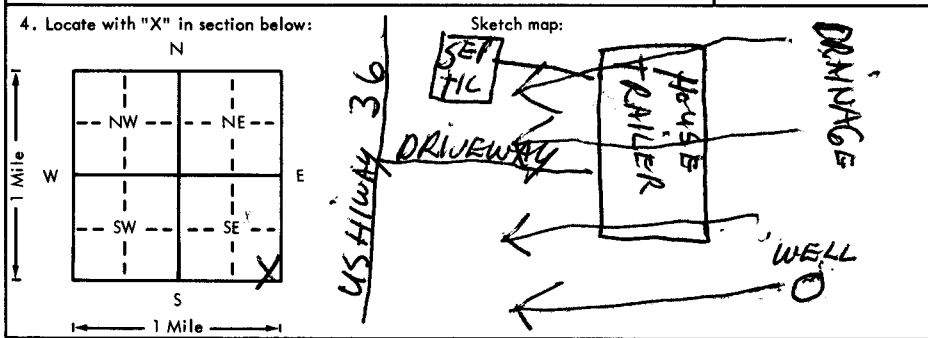

6. Bore hole dia. 34 in. Completion date 11/27/76
Well depth 39 ft. Bore Hole is 42" to 11'

7. Cable tool Rotary Driven Aug
 Hollow rod Jetted Bored Reverse rotary

8. Use: Domestic Public supply Industry
 Irrigation Air conditioning Stock
 Lawn Oil field water Other

9. Casing: Material concrete Above or below
Threaded Welded Surface 24 in.
RMP PVC Weight 200 lbs./ft.
Dia. 30 in. to 39 ft. depth; Wall Thickness: inches or
Dia. in. to ft. depth; gage No. 2 IN

5. Type and color of material	From	To
Yellow Windblown	0	6
Hard Yellow Wind Blown with streaks	6	14
Very Hard and Dry Yellow Clay	14	19
Soft Yellow Clay	19	21
Very Soft Yellow Clay with Black and Gray Streaks	21	33
Large Brown Sand - Gravel - Very Productive	33	37
Hard Blue Shale - Near Limestone	37	39
(Use a second sheet if needed)		

10. Screen: Manufacturer's name _____
Type _____ Dia. _____
Slot/gauze _____ Length _____
Set between _____ ft. and _____ ft.
_____ ft. and _____ ft.
Gravel pack? _____ Size range of material _____

11. Static water level: 22 ft. below land surface Date 11/26/76 mo./day/yr.
12. Pumping level below land surfaces:
_____ ft. after _____ hrs. pumping _____ g.p.m.
28 ft. after 2 hrs. pumping 4 g.p.m.
Estimated maximum yield 2 1/2 g.p.m.

13. Water sample submitted: _____ mo./day/yr.
Yes No Date _____

14. Well head completion:
_____ Pitless adapter _____ Inches above grade

15. Well grouted?
With: Neat cement Bentonite Concrete
Depth: From 0 ft. to 11 ft.

16. Nearest source of possible contamination:
ft. 130 Direction NW Type SEPTIC
Well disinfected upon completion? Yes No

17. Pump: Not installed
Manufacturer's name _____
Model number _____ HP _____ Volts _____
Length of drop pipe _____ ft. capacity _____ g.p.m.
Type:
 Submersible Turbine
 Jet Reciprocating
 Centrifugal Other

18. Elevation: 900'
Topography:
 Hill
 Slope
 Upland
 Valley

19. Remarks: Concrete slab and vent will be installed by customer. He knows and understands this is a regulation.
Larry Handley

20. Water well contractor's certification:
This well was drilled under my jurisdiction and this report is true to the best of my knowledge and belief.
POPPELWELL WELL BORING 320
Business name _____ License No. _____
Address Amity, MO 64422
Signed Jerry Poppelew Date 12/14/76
Authorized representative

T 2 200W 20 SE SE SE 1/4 1/4 1/4