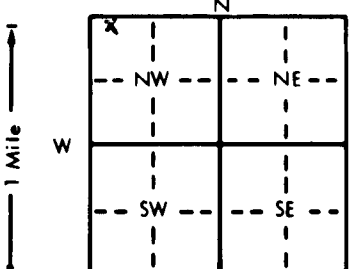


1 LOCATION OF WATER WELL: Fraction NW 1/4 NW 1/4 NW 1/4 Section Number 21 Township Number T 2 S Range Number R 20 E
 County: Douglas

Distance and direction from nearest town or city street address of well if located within city?
City of Sparks

2 WATER WELL OWNER: Hazel Simpson
 RR#, St. Address, Box #: RT 1 Box 115 Board of Agriculture, Division of Water Resources
 City, State, ZIP Code: Highland, KS 66035 Application Number:

3 LOCATE WELL'S LOCATION WITH AN "X" IN SECTION BOX:


4 DEPTH OF COMPLETED WELL: 6.2 ft. ELEVATION:
 Depth(s) Groundwater Encountered 1. 5.3 ft. 2. ft. 3. ft.
 WELL'S STATIC WATER LEVEL 1.3 ft. below land surface measured on mo/day/yr 3-12-88
 Pump test data: Well water was ft. after hours pumping gpm
 Est. Yield 5.0 gpm: Well water was ft. after hours pumping gpm
 Bore Hole Diameter: 8 in. to 6.2 ft., and in. to ft.
 WELL WATER TO BE USED AS: 5 Public water supply 8 Air conditioning 11 Injection well
 1 Domestic 3 Feedlot 6 Oil field water supply 9 Dewatering 12 Other (Specify below)
 2 Irrigation 4 Industrial 7 Lawn and garden only 10 Observation well
 Was a chemical/bacteriological sample submitted to Department? Yes.....No; If yes, mo/day/yr sample was submitted
 Water Well Disinfected? Yes No

5 TYPE OF BLANK CASING USED:
 1 Steel 3 RMP (SR) 5 Wrought iron 8 Concrete tile CASING JOINTS: Glued Clamped
 2 PVC 4 ABS 7 Fiberglass 9 Other (specify below) Welded
 Blank casing diameter 5 in. to 5.5 ft., Dia. in. to ft., Dia. in. to ft.
 Casing height above land surface 1.6 in., weight 2.843 lbs./ft. Wall thickness or gauge No. 0.265
 TYPE OF SCREEN OR PERFORATION MATERIAL:
 1 Steel 3 Stainless steel 5 Fiberglass 7 PVC 10 Asbestos-cement
 2 Brass 4 Galvanized steel 6 Concrete tile 8 RMP (SR) 11 Other (specify)
 SCREEN OR PERFORATION OPENINGS ARE:
 1 Continuous slot 3 Mill slot 5 Gauzed wrapped 8 Saw cut 11 None (open hole)
 2 Louvered shutter 4 Key punched 6 Wire wrapped 9 Drilled holes
 7 Torch cut 10 Other (specify)
 SCREEN-PERFORATED INTERVALS: From 5.5 ft. to 6.2 ft., From ft. to ft.
 From ft. to ft., From ft. to ft.
 GRAVEL PACK INTERVALS: From 4.0 ft. to 6.2 ft., From ft. to ft.
 From ft. to ft., From ft. to ft.

6 GROUT MATERIAL: 1 Neat cement 2 Cement grout 3 Bentonite 4 Other
 Grout Intervals: From 6 ft. to 2.2 ft., From ft. to ft., From ft. to ft.
 What is the nearest source of possible contamination:
 1 Septic tank 4 Lateral lines 7 Pit privy 10 Livestock pens 14 Abandoned water well
 2 Sewer lines 5 Cess pool 8 Sewage lagoon 11 Fuel storage 15 Oil well/Gas well
 3 Watertight sewer lines 6 Seepage pit 9 Feedyard 12 Fertilizer storage 16 Other (specify below)
 13 Insecticide storage
 Direction from well? North West How many feet? 75'

FROM	TO	LITHOLOGIC LOG	FROM	TO	LITHOLOGIC LOG
0	5	Silt clay BR			
5	28	Silt clay BR			
28	45.5	Silt clay GRAY			
45.5	48.5	SAND GRAY VF-F			
48.5	53	CLAY GRAY			
53	56	SAND VF-COARSE GRAY			
56	62.5	SAND & GRAVEL GRAY			

7 CONTRACTOR'S OR LANDOWNER'S CERTIFICATION: This water well was (1) constructed, (2) reconstructed, or (3) plugged under my jurisdiction and was completed on (mo/day/year) 3-12-88 and this record is true to the best of my knowledge and belief. Kansas
 Water Well Contractor's License No. 308 This Water Well Record was completed on (mo/day/yr) 4-1-88
 under the business name of Rioschek Drilling Co by (signature) Ray Rioschek

INSTRUCTIONS: Use typewriter or ball point pen. PLEASE PRESS FIRMLY and PRINT clearly. Please fill in blanks, underline or circle the correct answers. Send top three copies to Kansas Department of Health and Environment, Bureau of Water Protection, Topeka, Kansas 66620-7320, Telephone: 913-862-9360. Send one to WATER WELL OWNER and retain one for your records.