


1 LOCATION OF WATER WELL: Fraction SE 1/4 SE 1/4 SW 1/4 Section Number 27 Township Number T 02 S Range Number R 20 EW
 County: Doniphan Co. Kans.
 Distance and direction from nearest town or city street address of well if located within city?

5 1/2 miles northwest of Troy Kans.

2 WATER WELL OWNER: Leonard E. Twombly
 R.F. St. Address, Box #: RR 1 Box 133
 City, State, ZIP Code: Troy Kansas 66087
 Board of Agriculture, Division of Water Resources
 Application Number:

3 LOCATE WELL'S LOCATION WITH AN "X" IN SECTION BOX:

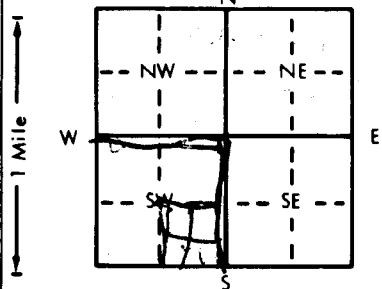

4 DEPTH OF COMPLETED WELL: 37 ft. ELEVATION: 27 ft.

Depth(s) Groundwater Encountered 1. 18 ft. 2. 27 ft. 3. 37 ft.

WELL'S STATIC WATER LEVEL 18 ft. below land surface measured on mo/day/yr 8-30-89

Pump test data: Well water was 32 ft. after 6 hours pumping 37 gpm

Est. Yield 3 gpm Well water was 32 ft. after 6 hours pumping 37 gpm

Bore Hole Diameter 34 in. to 20 ft. and 42 in. to 37 ft.

WELL WATER TO BE USED AS: 5 Public water supply 8 Air conditioning 11 Injection well
 1 Domestic 3 Feedlot 6 Oil field water supply 9 Dewatering 12 Other (Specify below)
 2 Irrigation 4 Industrial 7 Lawn and garden only 10 Monitoring well

Was a chemical/bacteriological sample submitted to Department? Yes No X; If yes, mo/day/yr sample was submitted

5 TYPE OF BLANK CASING USED: 5 Wrought iron 8 Concrete tile CASING JOINTS: Glued Clamped
 1 Steel 3 RMP (SR) 6 Asbestos-Cement 9 Other (specify below) Welded
 2 PVC 4 ABS 7 Fiberglass Threaded



TYPE OF SCREEN OR PERFORATION MATERIAL: 7 PVC 10 Asbestos-cement
 1 Steel 3 Stainless steel 5 Fiberglass 8 RMP (SR) 11 Other (specify)
 2 Brass 4 Galvanized steel 6 Concrete tile 9 ABS 12 None used (open hole)

SCREEN OR PERFORATION OPENINGS ARE: 5 Gauzed wrapped 8 Saw cut 11 None (open hole)
 1 Continuous slot 3 Mill slot 6 Wire wrapped 9 Drilled holes
 2 Louvered shutter 4 Key punched 7 Torch cut 10 Other (specify)





What is the nearest source of possible contamination: 10 Livestock pens 14 Abandoned water well
 1 Septic tank 4 Lateral lines 7 Pit privy 11 Fuel storage 15 Oil well/Gas well
 2 Sewer lines 5 Cess pool 8 Sewage lagoon 12 Fertilizer storage 16 Other (specify below)
 3 Watertight sewer lines 6 Seepage pit 9 Feedyard 13 Insecticide storage

Direction from well? How many feet? 250'

FROM	TO	LITHOLOGIC LOG	FROM	TO	PLUGGING INTERVALS
0	12	BLACK TOP SOIL			
12	9	GRAY SILTY CLAY			
9	13	BROWN WIND BLOWN			
13	21	YELLOW CLAY			
21	27	SANDY YELLOW CLAY			
27	33	JOINT CLAY - WET SAND + CLAY			
		PRODUCES WATER			
33	37	YELLOW CLAY			
		BOTTOM - YELLOW CLAY			

7 CONTRACTOR'S OR LANDOWNER'S CERTIFICATION: This water well was constructed (2) reconstructed, or (3) plugged under my jurisdiction and was completed on (mo/day/year) 8-30-89 and this record is true to the best of my knowledge and belief. Kansas Water Well Contractor's License No. 320 This Water Well Record was completed on (mo/day/yr) 9-3-89 under the business name of POPPLEWELL WELL BORING by (signature) Jerry Popplewell