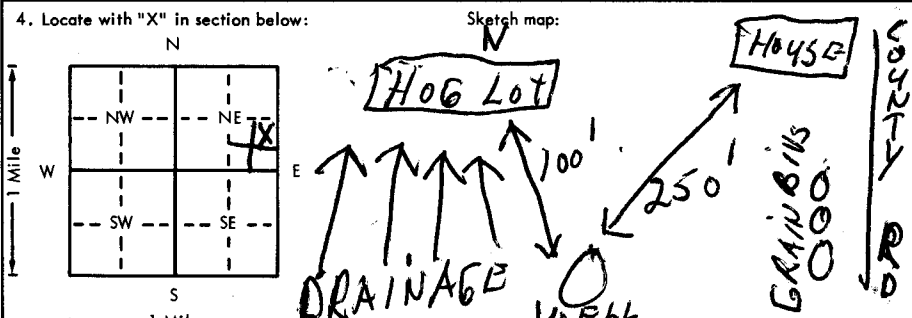


USE TYPEWRITER OR BALL POINT PEN-PRESS FIRMLY, PRINT CLEARLY.

WATER WELL RECORD
KSA 82a-1201-1215

Kansas Department of Health and Environment-Division of Environment (Water well Contractors) Topeka, Kansas 66620

1. Location of well:	County DONIPHAN	Fraction NE 1/4 SE 1/4 NE 1/4	Section number 32	Township number T 2 S	Range number R 20 E
2. Distance and direction from nearest town or city: 4 Miles east and 1/4 miles south of Highland, Kansas Street address of well location if in city:			3. Owner of well: William Saunders R.R. or street: RR 1 City, state, zip code: Troy, Kansas 66087		
4. Locate with "X" in section below: 			6. Bore hole dia. <u>34</u> in. Completion date <u>3/1/76</u> Well depth <u>62</u> ft. Bore Hole is <u>42</u> ft.		
5. Type and color of material			7. <input type="checkbox"/> Cable tool <input type="checkbox"/> Rotary <input type="checkbox"/> Driven <input type="checkbox"/> Aug <input type="checkbox"/> Hollow rod <input type="checkbox"/> Jetted <input checked="" type="checkbox"/> Bored <input type="checkbox"/> Reverse rotary		
Black Topsoil			8. Use: <input checked="" type="checkbox"/> Domestic <input type="checkbox"/> Public supply <input type="checkbox"/> Industry <input type="checkbox"/> Irrigation <input type="checkbox"/> Air conditioning <input type="checkbox"/> Stock <input type="checkbox"/> Lawn <input type="checkbox"/> Oil field water <input type="checkbox"/> Other		
Light Brown Windblown			9. Casing: Material <u>concrete</u> Height: <u>Above</u> or below Threaded <input type="checkbox"/> Welded <input type="checkbox"/> Surface <u>24</u> in. RMP <u>30</u> PVC <u>200</u> lbs./ft. Dia. <u>30</u> in. to <u>62</u> ft. depth; Wall Thickness: <u>2</u> in. Dia. <u> </u> in. to <u> </u> ft. depth; gage No. <u> </u>		
Brown Windblown			10. Screen: Manufacturer's name <u> </u> Type <u>None</u> Dia. <u> </u> Slot/gauze <u> </u> Length <u> </u> Set between <u> </u> ft. and <u> </u> ft. <u> </u> ft. and <u> </u> ft. Gravel pack? <input type="checkbox"/> Size range of material <u> </u>		
Brown and Light Brown			11. Static water level: <u>40</u> ft. below land surface Date <u>3/2/76</u> mo./day/yr.		
Windblown - Very Fine in Texture			12. Pumping level below land surfaces: <u>50</u> ft. after <u>1</u> hrs. pumping <u>4</u> g.p.m. <u>48</u> ft. after <u>2</u> hrs. pumping <u>4</u> g.p.m. Estimated maximum yield <u>5</u> g.p.m.		
Yellow Clay - Very Hard			13. Water sample submitted: <u> </u> mo./day/yr. Yes <input type="checkbox"/> No <input checked="" type="checkbox"/> Date <u> </u>		
Yellow - Brownish Sand - Very Coarse -			14. Well head completion: <input type="checkbox"/> Pitless adapter <u> </u> inches above grade		
Highly Productive			15. Well grouted? <input checked="" type="checkbox"/> With: <input checked="" type="checkbox"/> Neat cement <input type="checkbox"/> Bentonite <input type="checkbox"/> Concrete Depth: From <u>0</u> ft. to <u>11</u> ft.		
Limestone Rock			16. Nearest source of possible contamination: ft. <u>100</u> Direction <u>north</u> Type <u>Hog Lot</u> Well disinfected upon completion? <input checked="" type="checkbox"/> Yes <input type="checkbox"/> No		
(Use a second sheet if needed)			17. Pump: <input checked="" type="checkbox"/> Not installed Manufacturer's name <u> </u> Model number <u> </u> HP <u> </u> Volts <u> </u> Length of drop pipe <u> </u> ft. capacity <u> </u> g.p.m. Type: <input type="checkbox"/> Submersible <input type="checkbox"/> Turbine <input type="checkbox"/> Jet <input type="checkbox"/> Reciprocating <input type="checkbox"/> Centrifugal <input type="checkbox"/> Other		
18. Elevation: <u>1000</u> Topography: <input checked="" type="checkbox"/> Hill <input type="checkbox"/> Slope <input type="checkbox"/> Upland <input type="checkbox"/> Valley	19. Remarks: Concrete slab and vent will be installed by customer. He knows and understands that this is a regulation <i>William Saunders</i>		20. Water well contractor's certification: This well was drilled under my jurisdiction and this report is true to the best of my knowledge and belief. POPPELWELL WELL BORING 320 Business name <u>Amity, MO</u> License No. <u> </u> Address <u> </u> Signed <u>Jerry Poppe</u> Date <u>3/15/76</u> Authorized Representative		

Forward the white, blue and pink copies to the Department of Health and Environment

Form WWC-5

BR = 938 ∇ = 960