

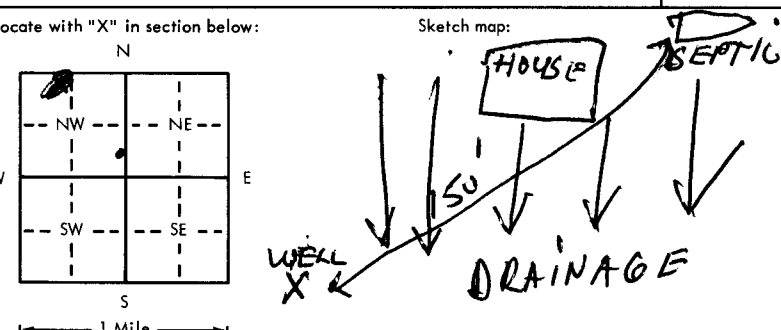
31

USE TYPEWRITER OR BALL
POINT PEN-PRESS FIRMLY,
PRINT CLEARLY.

WATER WELL RECORD
KSA 82a-1201-1215

Kansas Department of Health and
Environment-Division of Environment
(Water well Contractors)
Topeka, Kansas 66620

NE
CED - SE 1/4 - NW 1/4

1. Location of well:	County DONIPHAN	Fraction NE 1/4 NW 1/4	Section number 34	Township number T 2 S	Range number R 20 E
2. Distance and direction from nearest town or city: At North end of Fanning, Kansas Street address of well location if in city:			3. Owner of well: John Wiedmer R.R. or street: RR I City, state, zip code: Troy, Kansas		
4. Locate with "X" in section below: N W E S 1 Mile Sketch map: 			6. Bore hole dia. 34 in. Completion date 7/1/77 Well depth 42 ft. Bore hole is 42 ft. to 1		
			7. <input type="checkbox"/> Cable tool <input type="checkbox"/> Rotary <input type="checkbox"/> Driven <input type="checkbox"/> Dug <input type="checkbox"/> Hollow rod <input type="checkbox"/> Jetted <input checked="" type="checkbox"/> Bored <input type="checkbox"/> Reverse rotary		
			8. Use: <input checked="" type="checkbox"/> Domestic <input type="checkbox"/> Public supply <input type="checkbox"/> Industry <input type="checkbox"/> Irrigation <input type="checkbox"/> Air conditioning <input type="checkbox"/> Stock <input type="checkbox"/> Lawn <input type="checkbox"/> Oil field water <input type="checkbox"/> Other		
			9. Casing: Material concrete Above or below 24 in. Threaded <input type="checkbox"/> Welded <input type="checkbox"/> Surface <input type="checkbox"/> RMP <input type="checkbox"/> PVC <input type="checkbox"/> Weight 200 lbs./ft. Dia. 30 in. to 42 ft. depth Wall Thickness: inches or Dia. <input type="checkbox"/> in. to <input type="checkbox"/> ft. depth gage No. 2 in		
5. Type and color of material			From	To	10. Screen: Manufacturer's name
Black Silty Topsoil			0	3 1/2	Type <input type="checkbox"/> Dia.
Brown Wash In			3 1/2	9	Slot/gauze None Length
Blue/Gray Sandy Silt - Dry			9	18	Set between <input type="checkbox"/> ft. and <input type="checkbox"/> ft.
Sandy Blue/Gray Dirt - Produces some Water			18	34	Gravel pack? <input type="checkbox"/> Size range of material
Gray Sand w/ Small Pea Size Gravel - Water Producing			34	38	11. Static water level: <input type="checkbox"/> mo./day/yr. 18 ft. below land surface Date 7/1/77
Hard Blue Shale - Then Loose Limestone			38	42	12. Pumping level below land surfaces: 31 ft. after 3 hrs. pumping 10 g.p.m. <input type="checkbox"/> ft. after <input type="checkbox"/> hrs. pumping <input type="checkbox"/> g.p.m. Estimated maximum yield 1 1/2 g.p.m.
					13. Water sample submitted: <input type="checkbox"/> mo./day/yr. Yes <input checked="" type="checkbox"/> No Date
					14. Well head completion: <input type="checkbox"/> Pitless adapter <input type="checkbox"/> Inches above grade
					15. Well grouted? <input checked="" type="checkbox"/> With: <input checked="" type="checkbox"/> Neat cement <input type="checkbox"/> Bentonite <input type="checkbox"/> Concrete Depth: From 0 ft. to 11 ft.
					16. Nearest source of possible contamination: ft. 150 Direction NE Type SEPTIC Well disinfected upon completion? <input checked="" type="checkbox"/> Yes <input type="checkbox"/> No
					17. Pump: <input checked="" type="checkbox"/> Not installed Manufacturer's name Model number <input type="checkbox"/> HP <input type="checkbox"/> Volts <input type="checkbox"/> Length of drop pipe <input type="checkbox"/> ft. capacity <input type="checkbox"/> g.p.m. Type: <input type="checkbox"/> Submersible <input type="checkbox"/> Turbine <input type="checkbox"/> Jet <input type="checkbox"/> Reciprocating <input type="checkbox"/> Centrifugal <input type="checkbox"/> Other
					20. Water well contractor's certification: This well was drilled under my jurisdiction and this report is true to the best of my knowledge and belief. POPPLEWELL WELL BORING Business name Amity, MO License No. 64422 Address Amity, MO Signed Gray Popplewell Date 7/1/77 Authorized representative
18. Elevation: 877 Topography: <input type="checkbox"/> Hill <input type="checkbox"/> Slope <input checked="" type="checkbox"/> Upland <input checked="" type="checkbox"/> Valley			19. Remarks: Concrete slab and vent will be installed by customer. He knows and understands this is a regulation. John W. Wiedmer		

Forward the white, blue and pink copies to the Department of Health and Environment

Form WWC-5

BR = 839 ∇ = 846