


1 LOCATION OF WATER WELL: County: WASHINGTON	Fraction NE ¼ SE ¼ SE ¼	Section Number 17	Township Number T 2 S	Range Number R 3 E/W
---	----------------------------	----------------------	--------------------------	-------------------------

Distance and direction from nearest town or city street address of well if located within city?
4 1/2 north, 3 W. of Washington

2 WATER WELL OWNER: 3MK Pork L.L.C. (@ T.W. #13 site)
RR#, St. Address, Box #: Rt. 2 Box 97
City, State, ZIP Code: Washington, KS 66968
Board of Agriculture, Division of Water Resources
Application Number:

3 LOCATE WELL'S LOCATION WITH AN "X" IN SECTION BOX:

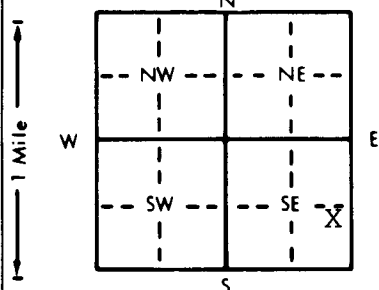

4 DEPTH OF COMPLETED WELL: 129' ft. ELEVATION:

Depth(s) Groundwater Encountered 1. ft. 2. ft. 3. ft.
WELL'S STATIC WATER LEVEL . 55' ft. below land surface measured on mo/day/yr 4/4/96.
Pump test data: Well water was ft. after hours pumping gpm
Est. Yield . 250 gpm: Well water was ft. after hours pumping gpm
Bore Hole Diameter . 36" in. to ft., and in. to ft.
WELL WATER TO BE USED AS: 5 Public water supply 8 Air conditioning 11 Injection well
1 Domestic 3 Feedlot 6 Oil field water supply 9 Dewatering 12 Other (Specify below)
2 Irrigation 4 Industrial 7 Lawn and garden only 10 Monitoring well
Was a chemical/bacteriological sample submitted to Department? Yes No X If yes, mo/day/yr sample was submitted
Water Well Disinfected? Yes X No

5 TYPE OF BLANK CASING USED:
1 Steel 3 RMP (SR) 5 Wrought iron 8 Concrete tile CASING JOINTS: Glued X Clamped
2 PVC 4 ABS 6 Asbestos-Cement 9 Other (specify below) Welded
7 Fiberglass Threaded

Blank casing diameter 16" in. to 0-99 ft. Dia in. to ft. Dia in. to ft.
Casing height above land surface 24" in., weight 1554 lbs./ft. Wall thickness or gauge No. 500

TYPE OF SCREEN OR PERFORATION MATERIAL: JOHNSON .030 slot 7 PVC 10 Asbestos-cement
1 Steel 3 Stainless steel 5 Fiberglass 8 RMP (SR) 11 Other (specify)
2 Brass 4 Galvanized steel 6 Concrete tile 9 ABS 12 None used (open hole)

SCREEN OR PERFORATION OPENINGS ARE:
1 Continuous slot 3 Mill slot 5 Gauzed wrapped 8 Saw cut 11 None (open hole)
2 Louvered shutter 4 Key punched 6 Wire wrapped 9 Drilled holes
7 Torch cut 10 Other (specify)

SCREEN-PERFORATED INTERVALS: From 99 ft. to 129 ft., From ft. to ft.
From ft. to ft., From ft. to ft.
GRAVEL PACK INTERVALS: From 20 ft. to 129 ft., From ft. to ft.
From ft. to ft., From ft. to ft.

6 GROUT MATERIAL: 1 Neat cement 2 Cement grout 3 Bentonite 4 Other
Grout Intervals: From 0 ft. to 20 ft., From 61 ft. to 71 ft., From ft. to ft.

What is the nearest source of possible contamination:
1 Septic tank 4 Lateral lines 7 Pit privy 10 Livestock pens 14 Abandoned water well
2 Sewer lines 5 Cess pool 8 Sewage lagoon 11 Fuel storage 15 Oil well/Gas well
3 Watertight sewer lines 6 Seepage pit 9 Feedyard 12 Fertilizer storage 16 Other (specify below)
13 Insecticide storage waterway

Direction from well? north How many feet? 50'

FROM	TO	LITHOLOGIC LOG	FROM	TO	PLUGGING INTERVALS
0	6	Fill	84	86	Shale-Tan
6	16	Clay-Tan	86	96	Sandstone-Brown
16	26	Clay-Grey	96	99	Sandstone-Brown-Courser
26	30	Fine Sand-Coarse Sand-Brown	99	99 1/2	Shale-Grey
30	34	Clay-Grey	99 1/2	102	Sandstone-Brown
34	44	Shale-Tan	102	103	Shale-Tan
44	54	Shale-Brown	103	108	Sandstone-Brown
54	67	Shale-Grey	108	109	Shale-Grey
67	68	Limestone-Iron	109	128	Sandstone-Brown
68	70	Shale-Grey	128	132	Limestone-Grey-Hard
70	74	Sandstone-Brown			
74	75	Shale-Grey			
75	78	Sandstone-Brown			
78	79	Shale-Grey			
79	84	Sandstone-Brown			

7 CONTRACTOR'S OR LANDOWNER'S CERTIFICATION: This water well was (1) constructed, (2) reconstructed, or (3) plugged under my jurisdiction and was completed on (mo/day/year) 4-04-96 and this record is true to the best of my knowledge and belief. Kansas Water Well Contractor's License No. 182 This Water Well Record was completed on (mo/day/yr) 4-12-96 under the business name of STRADER DRILLING CO., INC. by (signature) Dale Strader

INSTRUCTIONS: Use typewriter or ball point pen. PLEASE PRESS FIRMLY and PRINT clearly. Please fill in blanks, underline or circle the correct answers. Send top three copies to Kansas Department of Health and Environment, Bureau of Water, Topeka, Kansas 66620-0001. Telephone: 913-296-5545. Send one to WATER WELL OWNER and retain one for your records.