

CORRECTION TO WATER WELL RECORD (WWC-5)

The following correction(s) was made to the attached WWC-5 log, in order to file the item or to rectify lacking or incorrect information.

Fraction (1/4 1/4 1/4) Section-Township-Range changed:

listed as SE, NE, SE, sec. 17, T25S, R3E

changed to SE, NE, SE, sec. 17, T25, R3E

Other changes made:

Initial statements: _____

Changed to: _____

verification method: written description on form, & Washington, KS, 1:24,000 topo. map initials: RRJ date: 12/18/98


submitted by: Kansas Geological Survey, Data Resources Library, 1930 Constant Ave., Lawrence, KS 66047-3726
to: Kansas Dept of Health & Environment Bureau of Water Industrial Programs, Bldg 283, Forbes Field, KS 66620

1 LOCATION OF WATER WELL: Fraction SE 1/4 NE 1/4 SE 1/4 Section Number 17 Township Number T 25 2 S Range Number R 3 EW

Distance and direction from nearest town or city street address of well if located within city?
 4 1/2 north, 3 west of Washington

2 WATER WELL OWNER: 3MK Pork L.L.C. WELL # I-2
 RR#, St. Address, Box #: 2069 Prairie Road Board of Agriculture, Division of Water Resources
 City, State, ZIP Code: Washington, KS 66968-8620 Application Number:

3 LOCATE WELL'S LOCATION WITH AN "X" IN SECTION BOX:

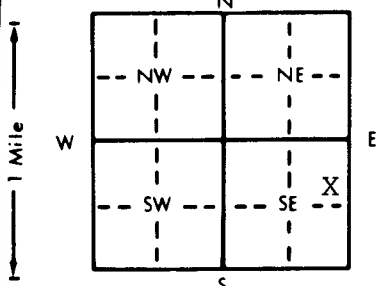

4 DEPTH OF COMPLETED WELL... 141' ft. ELEVATION: ...

Depth(s) Groundwater Encountered 1. 95-100 ft. 2. 100-122 ft. 3. 122-140 ft.
 WELL'S STATIC WATER LEVEL .69' .02 ft. below land surface measured on mo/day/yr 4-24-96
 Pump test data: Well water was ... ft. after ... hours pumping ... gpm
 Est. Yield .150 gpm: Well water was ... ft. after ... hours pumping ... gpm
 Bore Hole Diameter .18" in. to ... ft., and ... in. to ... ft.
 WELL WATER TO BE USED AS: 5 Public water supply 8 Air conditioning 11 Injection well
 1 Domestic 3 Feedlot 6 Oil field water supply 9 Dewatering 12 Other (Specify below)
 2 Irrigation 4 Industrial 7 Lawn and garden only 10 Monitoring well
 Was a chemical/bacteriological sample submitted to Department? Yes.....No...X.....; If yes, mo/day/yr sample was submitted
 Water Well Disinfected? Yes X No

5 TYPE OF BLANK CASING USED: 5 Wrought iron 8 Concrete tile CASING JOINTS: Glued X Clamped
 1 Steel 3 RMP (SR) 6 Asbestos-Cement 9 Other (specify below) Welded
 2 PVC 4 ABS 7 Fiberglass Threaded

Blank casing diameter 8" in. to 0-111 ft., Dia in. to ... ft., Dia in. to ... ft.
 Casing height above land surface 24" in., weight 5.58 lbs./ft. Wall thickness or gauge No. .332

TYPE OF SCREEN OR PERFORATION MATERIAL: JOHNSON .050 7 PVC 10 Asbestos-cement
 1 Steel 3 Stainless steel 5 Fiberglass 8 RMP (SR) 11 Other (specify)
 2 Brass 4 Galvanized steel 6 Concrete tile 9 ABS 12 None used (open hole)

SCREEN OR PERFORATION OPENINGS ARE: 5 Gauzed wrapped 8 Saw cut 11 None (open hole)
 1 Continuous slot 3 Mill slot 6 Wire wrapped 9 Drilled holes
 2 Louvered shutter 4 Key punched 7 Torch cut 10 Other (specify)

SCREEN-PERFORATED INTERVALS: From 111 ft. to 141 ft., From ... ft. to ... ft.
 GRAVEL PACK INTERVALS: From 90 ft. to 141 ft., From ... ft. to ... ft.

6 GROUT MATERIAL: 1 Neat cement 2 Cement grout 3 Bentonite 4 Other
 Grout Intervals: From 0 ft. to 20 ft., From ... ft. to ... ft., From ... ft. to ... ft.

What is the nearest source of possible contamination:
 1 Septic tank 4 Lateral lines 7 Pit privy 10 Livestock pens 14 Abandoned water well
 2 Sewer lines 5 Cess pool 8 Sewage lagoon 11 Fuel storage 15 Oil well/Gas well
 3 Watertight sewer lines 6 Seepage pit 9 Feedyard 12 Fertilizer storage 16 Other (specify below)
 13 Insecticide storage

Direction from well? How many feet?

| FROM | TO | LITHOLOGIC LOG | FROM | TO | PLUGGING INTERVALS |
|------|----|---------------------|--------|--------|--------------------|
| 0 | 2 | Top Soil | 90 | 91 | Sandstone-Brown |
| 2 | 7 | Clay-Brown | 91 | 97 | Shale-Grey |
| 7 | 19 | Clay-Tan | 97 | 97 1/2 | Limestone-Grey |
| 19 | 27 | FS-CS-Brown | 97 1/2 | 98 | Shale-Grey |
| 27 | 30 | Clay-Grey-Silty | 98 | 109 | Sandstone-Brown |
| 30 | 32 | Clay-Red | 109 | 114 | Sandstone-Yellow |
| 32 | 38 | Shale-Tan-Red | 114 | 115 | Shale-grey |
| 38 | 40 | Shale-Red | 115 | 139 | Sandstone-Brown |
| 40 | 45 | Shale-Tan-Brown | 139 | 142 | Shale-Grey |
| 45 | 52 | Shale-Grey-Brown | | | |
| 52 | 64 | Shale-Red-Grey | | | |
| 64 | 71 | Shale-Brown-Orange | | | |
| 71 | 73 | Shale-Tan | | | |
| 73 | 89 | Shale-Grey | | | |
| 89 | 90 | Iron pirate-LS Grey | | | |

7 CONTRACTOR'S OR LANDOWNER'S CERTIFICATION: This water well was (1) constructed, (2) reconstructed, or (3) plugged under my jurisdiction and was completed on (mo/day/year) 4-24-96 and this record is true to the best of my knowledge and belief. Kansas Water Well Contractor's License No. 182 This Water Well Record was completed on (mo/day/yr) 5-30-96 under the business name of STRADER DRILLING CO., INC. by (signature) Dale Osborn