

1] LOCATION OF WATER WELL: Fraction **SE ¼ SE ¼ SE ¼** Section Number **25** Township Number **T 2 S** Range Number **R 3 E/W**
 County: **Washington**

Distance and direction from nearest town or city street address of well if located within city?


2N, 1E & 1N of Washington

2] WATER WELL OWNER: **Pork Chop Acres Inc**

RR#, St. Address, Box # : **Rt2**
 City, State, ZIP Code : **Washington, KS 66968**

Board of Agriculture, Division of Water Resources
 Application Number:

3] LOCATE WELL'S LOCATION WITH AN "X" IN SECTION BOX:

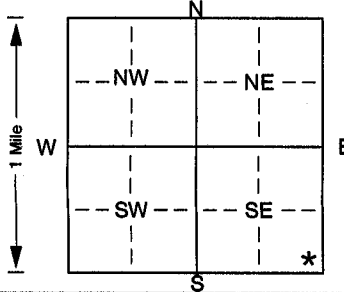

4] DEPTH OF COMPLETED WELL. **45** ft. ELEVATION:

Depth(s) Groundwater Encountered 1. ft. 2. ft. 3. ft.
 WELL'S STATIC WATER LEVEL **22** ft. below land surface measured on mo/day/yr **3/6/02**
 Pump test data: Well water was ft. after hours pumping gpm
 Est. Yield **30** gpm: Well water was ft. after hours pumping gpm
 Bore Hole Diameter. in. to ft., and in. to ft.

WELL WATER TO BE USED AS: 5 Public water supply 8 Air conditioning 11 Injection well
 1 Domestic 3 Feedlot 6 Oil field water supply 9 Dewatering 12 Other (Specify below)
 2 Irrigation 4 Industrial 7 Domestic (lawn & garden) 10 Monitoring well

Was a chemical/bacteriological sample submitted to Department? Yes. No. * ; If yes, mo/day/yrs sample was submitted
 Water Well Disinfected? Yes * No

5] TYPE OF BLANK CASING USED:

5 Wrought iron 8 Concrete tile CASING JOINTS: Glued. * Clamped.
 1 Steel 3 RMP (SR) 6 Asbestos-Cement 9 Other (specify below) Welded
 2 PVC 4 ABS 7 Fiberglass Threaded.

Blank casing diameter **5** in. to **25** ft., Dia in. to ft., Dia in. to ft.
 Casing height above land surface. **24** in., weight **2.00** lbs./ft. Wall thickness or gauge No. **265**

TYPE OF SCREEN OR PERFORATION MATERIAL:

1 Steel 3 Stainless steel 5 Fiberglass 7 PVC 10 Asbestos-cement
 2 Brass 4 Galvanized steel 6 Concrete tile 8 RMP (SR) 11 Other (specify)
 9 ABS 12 None used (open hole)

SCREEN OR PERFORATION OPENINGS ARE:

1 Continuous slot 3 Mill slot 5 Gauzed wrapped 8 Saw cut 11 None (open hole)
 2 Louvered shutter 4 Key punched 6 Wire wrapped 9 Drilled holes
 7 Torch cut 10 Other (specify) ft.

SCREEN-PERFORATED INTERVALS: From. **25** ft. to **45** ft., From ft. to ft.
 From. ft. to ft., From ft. to ft.
 GRAVEL PACK INTERVALS: From. **25** ft. to **45** ft., From ft. to ft.
 From. ft. to ft., From ft. to ft.

6] GROUT MATERIAL: 1 Neat cement 2 Cement grout 3 Bentonite 4 Other

Grout Intervals: From. **5** ft. to **25** ft., From ft. to ft., From ft. to ft.

What is the nearest source of possible contamination:

1 Septic tank 4 Lateral lines 7 Pit privy 10 Livestock pens 14 Abandoned water well
 2 Sewer lines 5 Cess pool 8 Sewage lagoon 11 Fuel storage 15 Oil well/Gas well
 3 Watertight sewer lines 6 Seepage pit 9 Feedyard 12 Fertilizer storage 16 Other (specify below)
 13 Insecticide storage

Direction from well? None Present How many feet?

FROM	TO	LITHOLOGIC LOG	FROM	TO	PLUGGING INTERVALS
0	5	Brown Clay			
5	20	Tan Clay & Sandstone			
20	38	Sandstone (Soft/Yellow)			
38	40	Blue Shale			

7] CONTRACTOR'S OR LANDOWNER'S CERTIFICATION: This water well was (1) constructed, (2) reconstructed, or (3) plugged under my jurisdiction and was completed on (mo/day/year) **3/6/02** and this record is true to the best of my knowledge and belief. Kansas Water Well Contractor's Licence No. **518** This Water Well Record was completed on (mo/day/yr) **3/10/02** under the business name of **Blue Valley Drilling** by (signature) *[Signature]*