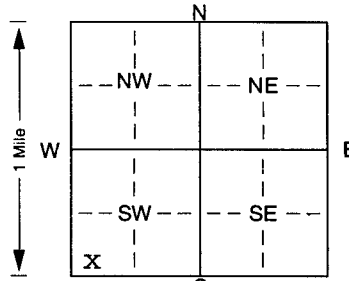


1 LOCATION OF WATER WELL: Fraction SW 1/4 SW 1/4 SW 1/4 Section Number 12 Township Number T 2 S Range Number R 3E EW
 County: Washington

Distance and direction from nearest town or city street address of well if located within city?
4 1/4 North of Washington in Washington Co

2 WATER WELL OWNER: Mick Walter
 RR#, St. Address, Box # : 2206 Quivira Rd Board of Agriculture, Division of Water Resources
 City, State, ZIP Code : Washington, Ks 66968 Application Number:

3 LOCATE WELL'S LOCATION WITH AN "X" IN SECTION BOX:

 4 DEPTH OF COMPLETED WELL... 120... ft. ELEVATION:
 Depth(s) Groundwater Encountered 1..... ft. 2..... ft. 3..... ft.
 WELL'S STATIC WATER LEVEL... 10... ft. below land surface measured on mo/day/yr 3-31-2003
 Pump test data: Well water was ft. after hours pumping gpm
 Est. Yield 4..... gpm: Well water was ft. after hours pumping gpm
 Bore Hole Diameter... 8 3/4 in. to ft., and in. to ft.
 WELL WATER TO BE USED AS: 5 Public water supply 8 Air conditioning 11 Injection well
1 Domestic 3 Feedlot 6 Oil field water supply 9 Dewatering 12 Other (Specify below)
 2 Irrigation 4 Industrial 7 Domestic (lawn & garden) 10 Monitoring well
 Was a chemical/bacteriological sample submitted to Department? Yes..... No. X...; If yes, mo/day/yrs sample was submitted Water Well Disinfected? Yes x No

5 TYPE OF BLANK CASING USED: 5 Wrought iron 8 Concrete tile CASING JOINTS: Glued. X Clamped.
 1 Steel 3 RMP (SR) 6 Asbestos-Cement 9 Other (specify below) Welded
 2 PVC 4 ABS 7 Fiberglass Threaded.....
 Blank casing diameter 5... in. to ft., Dia in. to ft., Dia in. to ft.
 Casing height above land surface... 24... in., weight 2.82... lbs./ft. Wall thickness or gauge No. 258
 TYPE OF SCREEN OR PERFORATION MATERIAL: 7 PVC 10 Asbestos-cement
 1 Steel 3 Stainless steel 5 Fiberglass 8 RMP (SR) 11 Other (specify)
 2 Brass 4 Galvanized steel 6 Concrete tile 9 ABS 12 None used (open hole)
 SCREEN OR PERFORATION OPENINGS ARE: 5 Gauzed wrapped 8 Saw cut 11 None (open hole)
 1 Continuous slot 3 Mill slot 6 Wire wrapped 9 Drilled holes
 2 Louvered shutter 4 Key punched 7 Torch cut 10 Other (specify) ft.
 SCREEN-PERFORATED INTERVALS: From... 15... ft. to... 19... ft., From... 50... ft. to... 70... ft.
 From... 110... ft. to... 112... ft., From... ft. to... ft.
 GRAVEL PACK INTERVALS: From... 12... ft. to... 120... ft., From... ft. to... ft.
 From... ft. to... ft., From... ft. to... ft.

6 GROUT MATERIAL: 1 Neat cement 2 Cement grout 3 Bentonite 4 Other
 Grout Intervals: From... 0... ft. to... 12... ft., From... ft. to... ft., From... ft. to... ft.
 What is the nearest source of possible contamination:
 1 Septic tank 4 Lateral lines 7 Pit privy 10 Livestock pens 14 Abandoned water well
 2 Sewer lines 5 Cess pool 8 Sewage lagoon 11 Fuel storage 15 Oil well/Gas well
 3 Watertight sewer lines 6 Seepage pit 9 Feedyard 12 Fertilizer storage 16 Other (specify below) Ditch
 13 Insecticide storage
 Direction from well? South How many feet? 30

FROM	TO	LITHOLOGIC LOG	FROM	TO	PLUGGING INTERVALS
0	2	top soil	80	82	brown shale
2	4	brown clay	82	83	grey limestone
4	7	sandy brown shale	83	85	grey sh shale
7	25	yellow & red shale	85	86	grey limestone
25	30	lite grey/sandy brn. shale	86	88	grey shale
30	33 33	red brown shale	88	98	grey hard grey limestone
33	35	tan grey shale	98	109	grey shale
35	51	grey & red shale	109	113	grey limestone
51	56	lite grey shale	113	117	blue grey shale
56	64	grey sandstone	117	120	brown shale
64	76	grey & brown shale			
76	77	grey limestone			shallow grout
77	80	grey & brown shale			

7 CONTRACTOR'S OR LANDOWNER'S CERTIFICATION: This water well was (1) constructed, (2) reconstructed, or (3) plugged under my jurisdiction and was completed on (mo/day/year) .. 4-8-2003... and this record is true to the best of my knowledge and belief. Kansas Water Well Contractor's Licence No. .. 182... This Water Well Record was completed on (mo/day/yr) .. 4-8-2003... under the business name of Strader Drilling Co., Inc by (signature) [Signature]