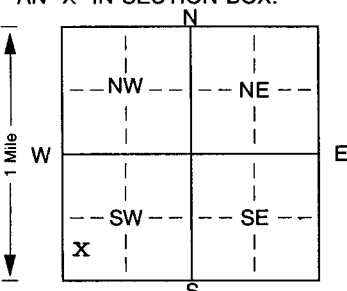


1 LOCATION OF WATER WELL: Fraction Section Number Township Number Range Number  
 County: ~~Washington~~ Wash. SW ¼ SW ¼ SW ¼ 12 T 2 S R 3E EW

Distance and direction from nearest town or city street address of well if located within city?  
 4 1/4 North Washington

2 WATER WELL OWNER: Mick Walter  
 RR#, St. Address, Box #: 2206 Quivira Rd Board of Agriculture, Division of Water Resources  
 City, State, ZIP Code: Washington, ks 66968 Application Number:

3 LOCATE WELL'S LOCATION WITH AN "X" IN SECTION BOX:  
  
 4 DEPTH OF COMPLETED WELL: 100 ft. ELEVATION:  
 Depth(s) Groundwater Encountered 1. . . . . ft. 2. . . . . ft. 3. . . . . ft.  
 WELL'S STATIC WATER LEVEL 68 . . . . . ft. below land surface measured on mo/day/yr 3-26-2003  
 Pump test data: Well water was . . . . . ft. after . . . . . hours pumping . . . . . gpm  
 Est. Yield 5 . . . . . gpm: Well water was . . . . . ft. after . . . . . hours pumping . . . . . gpm  
 Bore Hole Diameter: 8 3/4 in. to . . . . . ft., and . . . . . in. to . . . . . ft.  
 WELL WATER TO BE USED AS: 5 Public water supply 8 Air conditioning 11 Injection well  
 1 Domestic 3 Feedlot 6 Oil field water supply 9 Dewatering 12 Other (Specify below)  
 2 Irrigation 4 Industrial 7 Domestic (lawn & garden) 10 Monitoring well . . . . .  
 Was a chemical/bacteriological sample submitted to Department? Yes. . . . . No.  . . . . . ; If yes, mo/day/yr sample was submitted  
 Water Well Disinfected? Yes  No

5 TYPE OF BLANK CASING USED:  
 1 Steel 3 RMP (SR) 5 Wrought iron 8 Concrete tile CASING JOINTS: Glued.  Clamped. . . . .  
 2 PVC 4 ABS 6 Asbestos-Cement 9 Other (specify below) Welded . . . . .  
 7 Fiberglass . . . . . Threaded. . . . .  
 Blank casing diameter . . . . . 5 . . . . . in. to . . . . . ft., Dia . . . . . in. to . . . . . ft., Dia . . . . . in. to . . . . . ft.  
 Casing height above land surface. . . . . 24 . . . . . in., weight . . . . . 2.82 . . . . . lbs./ft. Wall thickness or gauge No. . . . . 258 . . . . .  
 TYPE OF SCREEN OR PERFORATION MATERIAL:  
 1 Steel 3 Stainless steel 5 Fiberglass 7 PVC 10 Asbestos-cement  
 2 Brass 4 Galvanized steel 6 Concrete tile 8 RMP (SR) 11 Other (specify) . . . . .  
 9 ABS 12 None used (open hole)  
 SCREEN OR PERFORATION OPENINGS ARE:  
 1 Continuous slot 3 Mill slot 5 Gauzed wrapped 8 Saw cut 11 None (open hole)  
 2 Louvered shutter 4 Key punched 6 Wire wrapped 9 Drilled holes  
 7 Torch cut 10 Other (specify) . . . . . ft.  
 SCREEN-PERFORATED INTERVALS: From . . . . . 60 . . . . . ft. to . . . . . 80 . . . . . ft., From . . . . . ft. to . . . . . ft.  
 From . . . . . 24 . . . . . ft. to . . . . . 100 . . . . . ft., From . . . . . ft. to . . . . . ft.  
 GRAVEL PACK INTERVALS: From . . . . . ft. to . . . . . ft., From . . . . . ft. to . . . . . ft.  
 From . . . . . ft. to . . . . . ft., From . . . . . ft. to . . . . . ft.

6 GROUT MATERIAL: 1 Neat cement 2 Cement grout 3 Bentonite 4 Other . . . . .  
 Grout Intervals: From . . . . . 4 . . . . . ft. to . . . . . 24 . . . . . ft., From . . . . . ft. to . . . . . ft., From . . . . . ft. to . . . . . ft.  
 What is the nearest source of possible contamination:  
 1 Septic tank 4 Lateral lines 7 Pit privy 10 Livestock pens 14 Abandoned water well  
 2 Sewer lines 5 Cess pool 8 Sewage lagoon 11 Fuel storage 15 Oil well/Gas well  
 3 Watertight sewer lines 6 Seepage pit 9 Feedyard 12 Fertilizer storage 16 Other (specify below)  
 Ditch  
 Direction from well? West How many feet? 100

FROM	TO	LITHOLOGIC LOG	FROM	TO	PLUGGING INTERVALS
0	2	top soil	46	49	red shale
2	7	brown clay	49	52	grey tan shale
7	9	brown sandy clay	52	53	brown sandy shale
9	12	lite brown clay	53	65	lite grey <del>shale</del> shale
12	15	red shale	65	72	grey <del>shale</del> sand stone
15	19	<del>tan</del> tan shale	72	74	grey shale
19	21	sandy brown shale	74	75	grey limestone
21	23	sandy tan <del>shale</del> shale	75	86	brown & grey shale
23	26	lite grey shale	86	88	grey limestone
26	27	dark grey shale	88	90	grey shale
27	32	lite grey shale	90	91	grey limestone
32	43	red shale	91	93	grey shale
43	45	tan shale	93	100	grey hard limestone
45	46	brown sandy shale			

7 CONTRACTOR'S OR LANDOWNER'S CERTIFICATION: This water well was (1) constructed, (2) reconstructed, or (3) plugged under my jurisdiction and was completed on (mo/day/year) . . . . . 4-8-2003 . . . . . and this record is true to the best of my knowledge and belief. Kansas Water Well Contractor's Licence No. . . . . 182 . . . . . This Water Well Record was completed on (mo/day/yr) . . . . . 4-8-2003 . . . . . under the business name of Strader Drilling Co., Inc. by (signature) *Dee Peterson*