


1 LOCATION OF WATER WELL: Fraction Section Number Township Number Range Number
 County: Washington SE 1/4 SW 1/4 SW 1/4 21 2 3 (EW)

Distance and direction from nearest town or city street address of well if located within city?
2 1/2 miles north, 2 3/4 miles west of Washington

2 WATER WELL OWNER: Leroy Long
 RR #, St. Address, Box #: 1523 20th Rd Board of Agriculture, Division of Water Resources
 City, State, ZIP Code: Washington, KS 66801 Application Number:

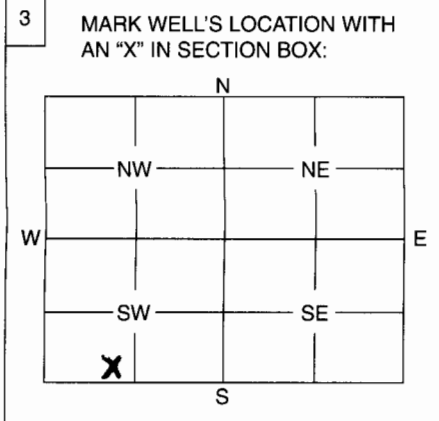

4 DEPTH OF WELL 80 ft.
 WELL'S STATIC WATER LEVEL 20 ft.
 WELL WAS USED AS:
 Domestic 5 Public Water Supply 9 Dewatering
 Irrigation 6 Oil Field Water Supply 10 Monitoring Well
 Feedlot 7 Domestic (Lawn & Garden) 11 Injection Well
 Industrial 8 Air Conditioning 12 Other
 Was a chemical / bacteriological sample submitted to Department? Yes No
 If yes, mo/day/yr sample was submitted
 Water Well Disinfected: Yes No

5 TYPE OF BLANK CASING USED:
 1 Steel 3 RMP (SR) 5 Wrought 7 Fiberglass Other (Specify below)
 2 PVC 4 ABS 6 Asbestos-Cement 8 Concrete Tile Rock
 Blank casing diameter in. Was casing pulled? Yes No If yes, how much
 Casing height above or below land surface in.

6 GROUT PLUG MATERIAL: 1 Neat cement 2 Cement grout Bentonite 4 Other
 Grout Plug Intervals: From 5 ft. to 4.5 ft., From ft. to ft., From to ft.
 What is the nearest source of possible contamination:
 1 Septic tank 6 Seepage pit 11 Fuel storage 16 Other (specify below)
 2 Sewer lines 7 Pit privy 12 Fertilizer storage
 3 Watertight sewer lines 8 Sewage lagoon 13 Insecticide storage
 4 Lateral lines 9 Feedyard 14 Abandoned water well
 5 Cess pool 10 Livestock pens 15 Oil well/Gas well
 Direction from well? How many feet?

FROM	TO	PLUGGING MATERIALS
<u>80 ft</u>	<u>60 ft</u>	<u>Chlorinated Sand</u>
<u>60 ft</u>	<u>5 ft</u>	<u>Subsoil fill</u>
<u>5 ft</u>	<u>4 1/2 ft</u>	<u>Bentonite Plug</u>
<u>4 1/2 ft</u>	<u>0 ft</u>	<u>Topsoil</u>

7 CONTRACTOR'S OF LANDOWNER'S CERTIFICATION: This water well was plugged under my jurisdiction and was completed on (mo/day/year) and this record is true to the best of my knowledge and belief. Kansas Water Well Contractor's License No. 7-11-06 under the business name of This Water Well Record was completed on (mo/day/year)
 by (signature) X Leroy Long

INSTRUCTIONS: Use typewriter or ball point pen. Please press firmly and print clearly. Please fill in blanks, underline or circle the correct answers. Send top three copies to Kansas Department of Health and Environment, Bureau of Water, Geology Section, 1000 SW Jackson St., Ste. 420, Topeka, Kansas 66612-1367. Telephone: 785/296-5522. Send one to Water Well Owner and retain one for your records.