


1 LOCATION OF WATER WELL: County: Washington Fraction: SW 1/4 NE 1/4 NE 1/4 Section Number: 15 Township Number: T 2 S Range Number: R 3 E

Distance and direction from nearest town or city street address of well if located within city?
3 N 1 W 3/4 N Washington

2 WATER WELL OWNER: Keescker Agri Business Inc.
 RR#, St. Address, Box #: R.R. Board of Agriculture, Division of Water Resources
 City, State, ZIP Code: Washington, Kansas 66968 Application Number:

3 LOCATE WELL'S LOCATION WITH AN "X" IN SECTION BOX: 4 DEPTH OF COMPLETED WELL: 80 ft. ELEVATION: 1350

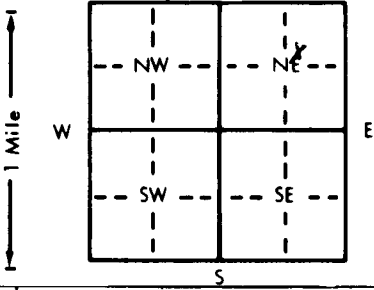

Depth(s) Groundwater Encountered 1. ft. 2. ft. 3. ft.
 WELL'S STATIC WATER LEVEL 53 ft. below land surface measured on mo/day/yr 5-10-89
 Pump test data: Well water was ft. after hours pumping gpm
 Est. Yield 50 gpm: Well water was ft. after hours pumping gpm
 Bore Hole Diameter: 9 in. to ft., and in. to ft.
 WELL WATER TO BE USED AS:
 1 Domestic 2 Feedlot 3 Public water supply 4 Air conditioning 5 Oil field water supply 6 Dewatering 7 Injection well
 8 Irrigation 9 Industrial 10 Lawn and garden only 11 Monitoring well 12 Other (Specify below)
 Was a chemical/bacteriological sample submitted to Department? Yes No ; If yes, mo/day/yr sample was submitted
 Water Well Disinfected? Yes No

5 TYPE OF BLANK CASING USED:
 1 Steel 2 PVC 3 RMP (SR) 4 ABS 5 Wrought iron 6 Asbestos-Cement 7 Fiberglass 8 Concrete tile 9 Other (specify below) CASING JOINTS: Glued Clamped
 Welded
 Threaded

Blank casing diameter: 5 in. to 60 ft., Dia. in. to ft., Dia. in. to ft.
 Casing height above land surface: 2K in., weight lbs./ft. Wall thickness or gauge No.

TYPE OF SCREEN OR PERFORATION MATERIAL:
 1 Steel 2 Brass 3 Stainless steel 4 Galvanized steel 5 Fiberglass 6 Concrete tile 7 PVC 8 RMP (SR) 9 ABS 10 Asbestos-cement 11 Other (specify) 12 None used (open hole)

SCREEN OR PERFORATION OPENINGS ARE:
 1 Continuous slot 2 Louvered shutter 3 Mill slot 4 Key punched 5 Gauzed wrapped 6 Wire wrapped 7 Torch cut 8 Saw cut 9 Drilled holes 10 Other (specify) 11 None (open hole)

SCREEN-PERFORATED INTERVALS: From 60 ft. to 80 ft., From ft. to ft.
 GRAVEL PACK INTERVALS: From 20 ft. to 80 ft., From ft. to ft.

6 GROUT MATERIAL: 1 Neat cement 2 Cement grout 3 Bentonite 4 Other
 Grout Intervals: From 0 ft. to 20 ft., From ft. to ft., From ft. to ft.

What is the nearest source of possible contamination:
 1 Septic tank 2 Sewer lines 3 Watertight sewer lines 4 Lateral lines 5 Cess pool 6 Seepage pit 7 Pit privy 8 Sewage lagoon 9 Feedyard 10 Livestock pens 11 Fuel storage 12 Fertilizer storage 13 Insecticide storage 14 Abandoned water well 15 Oil well/Gas well 16 Other (specify below)

Direction from well? NE How many feet? 1000

FROM	TO	LITHOLOGIC LOG	FROM	TO	PLUGGING INTERVALS
0	9	Brown Clay			
9	19	Tan Clay			
19	50	gray clay			
50	70	Sandstone yellow			

7 CONTRACTOR'S OR LANDOWNER'S CERTIFICATION: This water well was (1) constructed, (2) reconstructed, or (3) plugged under my jurisdiction and was completed on (mo/day/year) 5-10-89 and this record is true to the best of my knowledge and belief. Kansas Water Well Contractor's License No. 234 This Water Well Record was completed on (mo/day/yr) under the business name of Blue Valley Drilling by (signature) Betty Jo Strader