

USE TYPEWRITER OR BALL POINT PEN-PRESS FIRMLY, PRINT CLEARLY.

WATER WELL RECORD  
KSA 82a-1201-1215


T R EW sec 1/4 1/4 1/4 No.

Kansas State Dept. Of Health  
(Water Well Contractors)  
Forbes-Bldg. 740  
Topeka, Kansas 66620

1 Location of well: County WASHINGTON Township name FARMINGTON Fraction CSE 1/4 Section number 18 Town number T2S Range number R3E

Distance and direction from nearest town or city: 2 NORTH  
Street address of well location if in city: 3 1/2 EAST OF MORROWVILLE

3 Owner of well: LAURENCE DILLER  
Address: MORROWVILLE, KANS

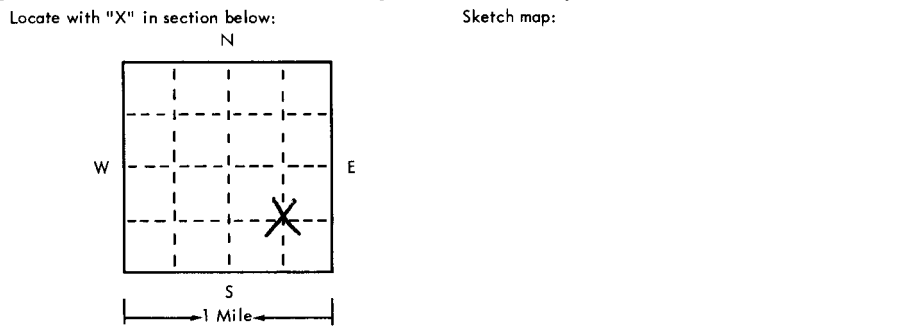

4 Well depth: 168 ft. Date of completion 11/16/75  
Well diameter 6 in.

5  Cable tool  Rotary  Driven  Dug  
 Hollow rod  Jetted  Bored  Reverse rotary

6 Use:  Domestic  Public supply  Industry  
 Irrigation  Air conditioning  Commercial  
 Test well

7 Casing: Material \_\_\_\_\_ Height: above/below  
Threaded  Welded  Surface \_\_\_\_\_ in.  
Diam. \_\_\_\_\_ Weight \_\_\_\_\_ lbs./ft. \_\_\_\_\_  
\_\_\_\_\_ in. to \_\_\_\_\_ ft. depth Drive shoe?  Yes  No  
\_\_\_\_\_ in. to \_\_\_\_\_ ft. depth

2	Type and color of material	From	To
	Black topsoil	0	2
	brown clay	2	30
	brown sandy clay	30	45
	brown sand	45	51
	gray clay	51	67
	gray clay w/rock layers	67	75
	brown sandrock	75	89
	gray clay	89	114
	brown sandrock	114	120
	brown hard rock	120	121
	brown sandrock	121	153
	gray clay	153	155
	hard rock	155	163
	blue shale	163	168
	stop	168	

8 Screen: Manufacturer \_\_\_\_\_  
Type \_\_\_\_\_ Dia. \_\_\_\_\_  
Slot/gauze \_\_\_\_\_ Length \_\_\_\_\_  
Set between \_\_\_\_\_ ft. and \_\_\_\_\_ ft. \_\_\_\_\_  
Fittings: Gravel pack  Yes  No Size range of material \_\_\_\_\_

9 Static water level: \_\_\_\_\_ ft. below land surface Date \_\_\_\_\_

10 Pumping level below land surfaces:  
\_\_\_\_\_ ft. after \_\_\_\_\_ hrs. pumping \_\_\_\_\_ g.p.m.  
\_\_\_\_\_ ft. after \_\_\_\_\_ hrs. pumping \_\_\_\_\_ g.p.m.  
Estimated maximum yield \_\_\_\_\_ g.p.m.

11 Water sample submitted:  Yes  No Date \_\_\_\_\_

12 Well head completion:  Pitless adapter  Inches above grade

13 Well cased?  Yes  No  
 Cement  Benignite  D  
Depth: From \_\_\_\_\_ ft. to \_\_\_\_\_ ft.

14 Nearest source of possible contamination:  
ft. \_\_\_\_\_ Direction \_\_\_\_\_ Type \_\_\_\_\_  
Well disinfected upon completion?  Yes  No

15 Pump:  Not installed  
Manufacturer's name \_\_\_\_\_  
Model number \_\_\_\_\_ HP \_\_\_\_\_ Volts \_\_\_\_\_  
Length of drop pipe \_\_\_\_\_ ft. capacity \_\_\_\_\_ g.m.p.  
Type:  
 Submersible  Turbine  
 Jet  Reciprocating  
 Centrifugal  Other

16 Remarks: elevation 1400  
Topography: A test hole water was salty  
 Hill  Slope  Upland  Valley

17 Water well contractor's certification:  
This well was drilled under my jurisdiction and this report is true to the best of my knowledge and belief.  
GEO COX + SONS INC 258  
Business name License No. \_\_\_\_\_  
Address: WILTON, KANSAS  
Signed: Geoff Cox Date 10/21/75  
Authorized representative