

USE TYPEWRITER OR BALL POINT PEN—PRESS FIRMLY, PRINT CLEARLY.

SW SE SE
WATER WELL RECORD
KSA 82a-1201-1215


T R EW sec 1/4 1/4 1/4 No.

Kansas State Dept. Of Health
(Water Well Contractors)
Forbes-Bldg. 740
Topeka, Kansas 66620

C 5 1/2 of 5 1/2

1 Location of well: County WASHINGTON Township name FAIRMINGTON Fraction SE 1/4 Section number 18 Town number T2 S Range number R 3 E

Distance and direction from nearest town or city: 2 NORTH 3 1/2 EAST OF MORROWVILLE
Street address of well location if in city: MORROWVILLE
3 Owner of well: LAWRENCE DILLER
Address: MORROWVILLE, KANSAS

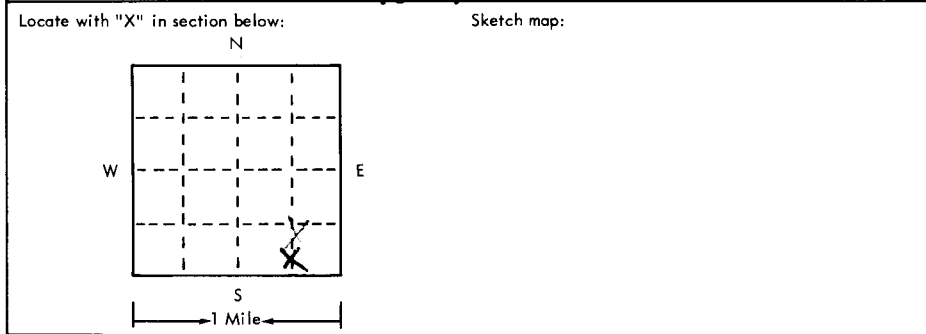

4 Well depth: 154 ft. Date of completion 11/16/75
Well diameter 20 in.
5 Cable tool Rotary Driven Dug
 Hollow rod Jetted Bored Reverse rotary
6 Use: Domestic Public supply Industry
 Irrigation Air conditioning Commercial
 Test well _____
7 Casing: Material AC Height: above below
Threaded Welded Surface 12 in.
Diam. 1 1/2 in. to 1 3/4 ft. depth Weight 30 lbs./ft.
Drive shoe? Yes No
12 in. to 154 ft. depth

2	Type and color of material	From	To
	TOPSOIL BLACK	0	3
	CLAY GRAY	3	70
	SHALE BLUE	70	94
	SANDROCK BROWN	94	97
	SANDROCK GRAY	97	104
	SHALE BLUE	104	106
	SANDROCK GRAY	106	153
	SHALE BLUE	153	154
	STOP	154	

8 Screen: Manufacturer JOHNSON CONCRETE
Type AC Dia. 12"
Slot/gauze 1/8" Length 39'
Set between 43 ft. and 154 ft.
Fittings: Gravel pack Yes No Size range of material 1/4" x 1/2"
9 Static water level: 30 ft. below land surface Date 11/16/75
10 Pumping level below land surfaces:
150 ft. after 1 hrs. pumping 435 g.p.m.
____ ft. after ____ hrs. pumping ____ g.p.m.
Estimated maximum yield 435 g.p.m.
11 Water sample submitted:
 Yes No Date _____
12 Well head completion:
 Pitless adapter Inches above grade
13 Well grouted? Yes No
 Neat cement Bentonite _____
Depth: From 0 ft. to 10 ft.
14 Nearest source of possible contamination:
ft. 2000 Direction WEST Type CREEK
Well disinfected upon completion? Yes No
15 Pump: Not installed
Manufacturer's name WESTERN LANDROLLER
Model number _____ HP 60 Volts 440
Length of drop pipe 145 ft. capacity 425 g.p.m.
Type:
 Submersible Turbine
 Jet Reciprocating
 Centrifugal Other

16 Remarks: elevation 1390
Topography:
 Hill
 Slope
 Upland
 Valley
(use a second sheet if needed)

17 Water well contractor's certification:
This well was drilled under my jurisdiction and this report is true to the best of my knowledge and belief.
GEO COX & SONS INC 358
Business name _____ License No. _____
Address LYNETON, KANSAS
Signed Larry Diller Date 11/16/75
Authorized representative