


USE TYPEWRITER OR BALL POINT PEN-PRESS FIRMLY, PRINT CLEARLY.

WATER WELL RECORD
KSA 82a-1201-1215

Kansas Department of Health and Environment-Division of Environment (Water well Contractors) Topeka, Kansas 66620

1. Location of well: County WASHINGTON Fraction C 1/4 NW 1/4 Section number 19 Township number T 2 S Range number R 3 E/W

2. Distance and direction from nearest town or city: 2 N - 2 E
Street address of well location if in city: MORROWVILLE.
3. Owner of well: LAWRENCE PILLER
R.R. or street: RURAL ROUTE
City, state, zip code: MORROWVILLE, KANS 66958

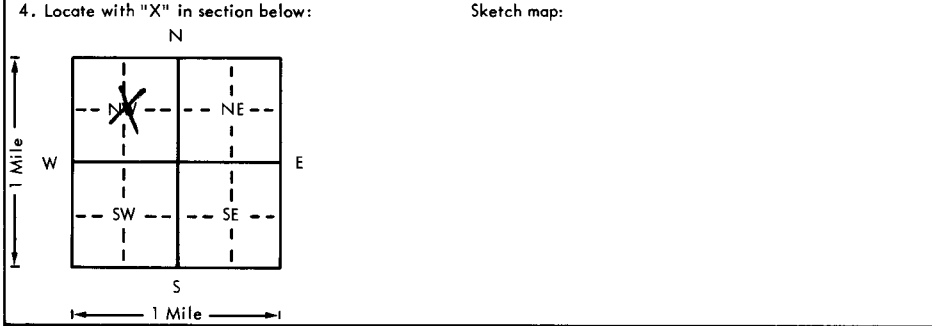

6. Bore hole dia. 22 in. Completion date 11-23-77
Well depth 122 ft.
7. Cable tool Rotary Driven Dug
 Hollow rod Jetted Bored Reverse rotary
8. Use: Domestic Public supply Industry
 Irrigation Air conditioning Stock
 Lawn Oil field water Other
9. Casing: Material AC Height Above or below
Threaded Welded Surface 18 in.
RMP PVC Weight 30 lbs./ft.
Dia. 12 in. to 122 ft. depth Wall Thickness: inches or
Dia. in. to ft. depth gage No. 34 "

5. Type and color of material	From	To
<u>TOPSOIL</u>	<u>0</u>	<u>3</u>
<u>BROWN CLAY</u>	<u>3</u>	<u>10</u>
<u>SANDY CLAY</u>	<u>10</u>	<u>34</u>
<u>BLUE CLAY</u>	<u>34</u>	<u>42</u>
<u>SANDY CLAY</u>	<u>42</u>	<u>51</u>
<u>SAND</u>	<u>51</u>	<u>54</u>
<u>GRAY CLAY</u>	<u>54</u>	<u>56</u>
<u>SANDROCK</u>	<u>56</u>	<u>108</u>
<u>BLUE CLAY</u>	<u>108</u>	<u>110</u>
<u>SANDROCK</u>	<u>110</u>	<u>123</u>
<u>BLUE SHALE</u>	<u>123</u>	<u>136</u>
<u>STOP</u>	<u>136</u>	

10. Screen: Manufacturer's name JOHANSON CONCRETE
Type A-CEMENT Dia. 12
Slot gauge 1/8" Length 39
Set between 83 ft. and 122 ft.
ft. and ft.
Gravel pack? Yes Size range of material 4x5
11. Static water level: 40 mo./day/yr.
40 ft. below land surface Date 11-23-77
12. Pumping level below land surfaces:
 ft. after hrs. pumping g.p.m.
 ft. after hrs. pumping g.p.m.
Estimated maximum yield 575 g.p.m.
13. Water sample submitted: mo./day/yr.
 Yes No Date
14. Well head completion:
 Pitless adapter 18 Inches above grade
15. Well grouted? Yes
With: Neat cement Bentonite Concrete
Depth: From 0 ft. to 10 ft.
16. Nearest source of possible contamination:
ft. 200 Direction EAST Type CREEK
Well disinfected upon completion? Yes No
17. Pump: Not installed
Manufacturer's name
Model number HP Volts
Length of drop pipe ft. capacity g.p.m.
Type:
 Submersible Turbine
 Jet Reciprocating
 Centrifugal Other

18. Elevation:
Topography:
 Hill
 Slope
 Upland
 Valley

19. Remarks:

20. Water well contractor's certification:
This well was drilled under my jurisdiction and this report is true to the best of my knowledge and belief.
Geo Cox + Sons Inc 258
Business name License No.
Address CLIFTON KANS 66937
Signed Harold Cox Date 12-1-77
Authorized representative

T
R
W
E
S
C
19
1/4
1/4
1/4
C
M
D