


USE TYPEWRITER OR BALL POINT PEN-PRESS FIRMLY, PRINT CLEARLY.

WATER WELL RECORD
KSA 82a-1201-1215

Kansas Department of Health and Environment-Division of Environment
(Water well Contractors)
Topeka, Kansas 66620

1. Location of well: County Washington Fraction NW 1/4 SE 1/4 SE 1/4 Section number 21 Township number T 2 S R 3 Range number EW

2. Distance and direction from nearest town or city: 3 N - 2 1/2 W 3. Owner of well: John Stigge
Street address of well location if in city: of Washington R.R. or street: #1
City, state, zip code: Washington Ks 66968

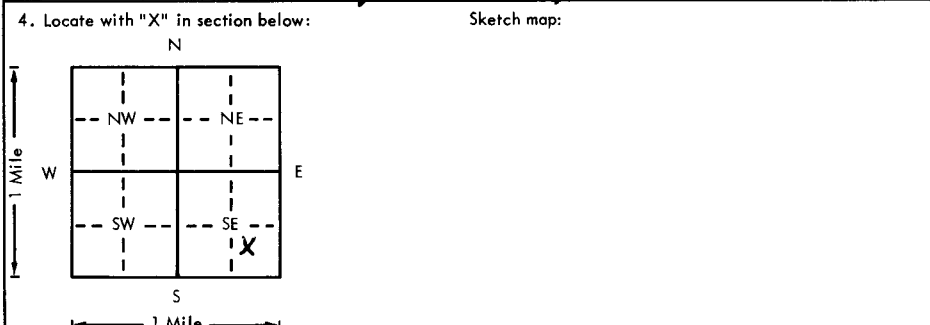

6. Bore hole dia. 20' in. Completion date _____
Well depth 145 ft. 6-19-76

7. Cable tool Rotary Driven Dug
 Hollow rod Jetted Bored Reverse rotary

8. Use: Domestic Public supply Industry
 Irrigation Air conditioning Stock
 Lawn Oil field water Other

9. Casing: Material AC Height: Above or below _____
Threaded _____ Welded _____ Surface 12 in.
RMP _____ PVC _____ Weight 24 lbs./ft.
Dia. 12 in. to 145 ft. depth Wall Thickness: inches or _____
Dia. _____ in. to _____ ft. depth gage No. 3/4

5. Type and color of material	From	To
<u>top soil + clay</u>	<u>0</u>	<u>16</u>
<u>sandy clay</u>	<u>16</u>	<u>48</u>
<u>sand</u>	<u>48</u>	<u>54</u>
<u>gravel</u>	<u>54</u>	<u>64</u>
<u>sand rock</u>	<u>64</u>	<u>93</u>
<u>gray clay</u>	<u>93</u>	<u>103</u>
<u>sand rock</u>	<u>103</u>	<u>145</u>
<u>blue shale</u>	<u>145</u>	<u>150</u>

10. Screen: Manufacturer's name Johnson
Concrete
Type transit Dia. 12
Slot/gauge 1/8 Length 42
Set between 103 ft. and 145 ft.
_____ ft. and _____ ft.
Gravel pack? YES Size range of material 1/8-1/4

11. Static water level: _____ mo./day/yr.
30 ft. below land surface Date 6-19-76

12. Pumping level below land surfaces:
142 ft. after 1 hrs. pumping 450 g.p.m.
_____ ft. after _____ hrs. pumping _____ g.p.m.
Estimated maximum yield 450 g.p.m.

13. Water sample submitted: _____ mo./day/yr.
 Yes No Date _____

14. Well head completion: _____
 Pitless adapter 12 Inches above grade

15. Well grouted? _____
With: Neat cement Bentonite Concrete
Depth: From _____ ft. to _____ ft.

16. Nearest source of possible contamination:
ft. _____ Direction _____ Type _____
Well disinfected upon completion? Yes No

17. Pump: _____ Not installed
Manufacturer's name Jaruzzi
Model number LR 60 HP 60 Volts 480
Length of drop pipe 142 ft. capacity 450 g.p.m.
Type: _____
 Submersible Turbine
 Jet Reciprocating
 Centrifugal Other

18. Elevation: _____

19. Remarks: _____

Topography:
 Hill
 Slope
 Upland
 Valley

20. Water well contractor's certification:
This well was drilled under my jurisdiction and this report is true to the best of my knowledge and belief.
Eric Cox + Sons Inc 258
Business name _____ License No. _____
Address Clifton Kansas
Signed Thomas Cox Date 6-19-76
Authorized representative