


USE TYPEWRITER OR BALL POINT PEN-PRESS FIRMLY, PRINT CLEARLY.

WATER WELL RECORD
KSA 82a-1201-1215

Kansas Department of Health and Environment-Division of Environment
(Water well Contractors)
Topeka, Kansas 66620

1. Location of well: County WASHINGTON Fraction NE 1/4 NE 1/4 SE 1/4 Section number 27 Township number T 2 S Range number R 3 E

2. Distance and direction from nearest town or city: 2 N-2 W 3. Owner of well: LARRY GRAYM
Street address of well location if in city: WASHINGTON R.R. or street: RR # 2
City, state, zip code: WASHINGTON, KANS 66968

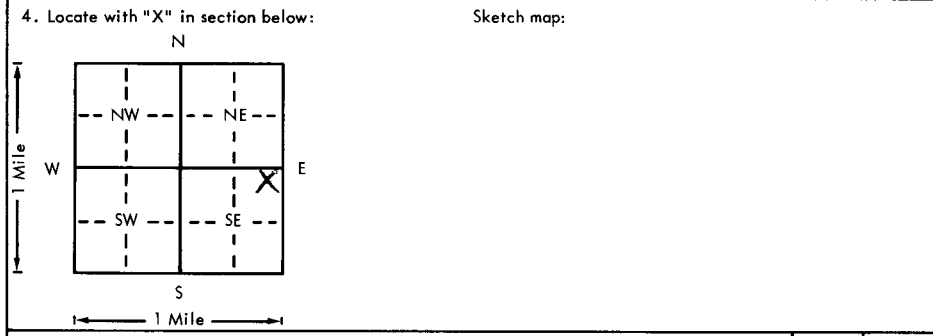

6. Bore hole dia. 8 in. Completion date 9-30-78
Well depth 85 ft.

7. Cable tool Rotary Driven Dug
 Hollow rod Jetted Bored Reverse rotary

8. Use: Domestic Public supply Industry
 Irrigation Air conditioning Stock
 Lawn Oil field water Other

9. Casing: Material PVC Height: Above or below
Threaded Welded Surface 12 in.
RMP PVC Weight 3 lbs./ft.
Dia. 5 in. to 85 ft. depth Wall Thickness: inches or
Dia. in. to ft. depth gage No. 1258

5. Type and color of material	From	To
<u>TOPSOIL</u>	<u>0</u>	<u>3</u>
<u>BROWN CLAY</u>	<u>3</u>	<u>10</u>
<u>SANDROCK</u>	<u>10</u>	<u>62</u>
<u>BLUE CLAY</u>	<u>62</u>	<u>64</u>
<u>SANDROCK</u>	<u>64</u>	<u>82</u>
<u>BLUE SHALE</u>	<u>82</u>	<u>85</u>
<u>STOP</u>	<u>85</u>	

10. Screen: Manufacturer's name PUMPCO
Type PVC Dia. 5"
Slot gauge 1/16 Length 20'
Set between 65 ft. and 85 ft.
Gravel pack? YES Size range of material 8x14

11. Static water level: 50 ft. below land surface Date 9-30-78 mo./day/yr.

12. Pumping level below land surfaces:
 ft. after MA hrs. pumping g.p.m.
 ft. after hrs. pumping g.p.m.
Estimated maximum yield 15 g.p.m.

13. Water sample submitted: mo./day/yr.
 Yes No Date

14. Well head completion:
 Pitless adapter 12 Inches above grade

15. Well grouted? YES
With: Neat cement Bentonite Concrete
Depth: From 3 ft. to 13 ft.

16. Nearest source of possible contamination: SOUTH SEPTIC
ft. 2000 Direction WEST Type TANK
Well disinfected upon completion? Yes No

17. Pump: Not installed
Manufacturer's name
Model number HP Volts
Length of drop pipe ft. capacity g.p.m.
Type:
 Submersible Turbine
 Jet Reciprocating
 Centrifugal Other

18. Elevation: 410
Topography: Hill Slope Upland Valley

19. Remarks:

20. Water well contractor's certification:
This well was drilled under my jurisdiction and this report is true to the best of my knowledge and belief. 359
DARYL COX + SONS INC
Business name License No.
Address ELLIOTTS KANSAS 66937
Signed Daryl Cox Date 10-3-78
Authorized representative

T 2 S R 3 E NE SE