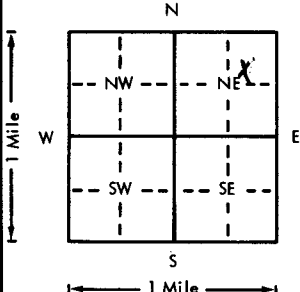


USE TYPEWRITER OR BALL POINT PEN-PRESS FIRMLY, PRINT CLEARLY.

WATER WELL RECORD
KSA 82a-1201-1215

Kansas Department of Health and Environment-Division of Environment
(Water well Contractors)
Topeka, Kansas 66620

1. Location of well:	County WASHINGTON	Fraction SW 1/4 NE 1/4 NE 1/4	Section number 32	Township number T 2 S	Range number R 3 E
2. Distance and direction from nearest town or city: Street address of well location if in city:	2 N 3 W WASHINGTON		3. Owner of well: R.R. or street: City, state, zip code:		
4. Locate with "X" in section below: Sketch map: 			6. Bore hole dia. 8 in. Completion date _____ Well depth 89 ft. 7/8/76		
5. Type and color of material			From	To	7. <input checked="" type="checkbox"/> Cable tool <input checked="" type="checkbox"/> Rotary <input type="checkbox"/> Driven <input type="checkbox"/> Dug <input type="checkbox"/> Hollow rod <input type="checkbox"/> Jetted <input type="checkbox"/> Bored <input type="checkbox"/> Reverse rotary
					8. Use: <input checked="" type="checkbox"/> Domestic <input type="checkbox"/> Public supply <input type="checkbox"/> Industry <input type="checkbox"/> Irrigation <input type="checkbox"/> Air conditioning <input type="checkbox"/> Stock <input type="checkbox"/> Lawn <input type="checkbox"/> Oil field water <input type="checkbox"/> Other
TOPSOIL			0	2	9. Casing: Material PVC Height Above or below Threaded <input type="checkbox"/> Welded <input checked="" type="checkbox"/> Surface 15 in. RMP <input type="checkbox"/> PVC <input checked="" type="checkbox"/> Weight 3 lbs./ft. Dia. 5 in. to 89 ft. depth Wall Thickness: inches or Dia. _____ in. to _____ ft. depth gage No. 1214
BROWN CLAY			2	31	10. Screen: Manufacturer's name _____ PUMPO Type PVC Dia. 5" Slot/gauze 1/4" Length 20' Set between 69 ft. and 89 ft. _____ ft. and _____ ft. Gravel pack? YES Size range of material 1/8" x 1/4"
RED SANDY CLAY			31	34	11. Static water level: _____ mo./day/yr. 21 ft. below land surface Date 7/8/76
GRAVEL			34	37	12. Pumping level below land surface: _____ ft. after _____ hrs. pumping _____ g.p.m. _____ ft. after N/A hrs. pumping _____ g.p.m. Estimated maximum yield 50 g.p.m.
SANDROCK			37	88	13. Water sample submitted: _____ mo./day/yr. <input type="checkbox"/> Yes <input checked="" type="checkbox"/> No Date _____
GRAY CLAY			88	89	14. Well head completion: <input checked="" type="checkbox"/> Pitless adapter 15 Inches above grade
STOP			89		15. Well grouted? YES With: <input checked="" type="checkbox"/> Neat cement <input type="checkbox"/> Bentonite <input type="checkbox"/> Concrete Depth: From 3 ft. to 13 ft.
					16. Nearest source of possible contamination: ft. 100 Direction WEST Type SEPTIC TANK Well disinfected upon completion? <input checked="" type="checkbox"/> Yes <input type="checkbox"/> No
					17. Pump: <input checked="" type="checkbox"/> Not installed Manufacturer's name _____ Model number _____ HP _____ Volts _____ Length of drop pipe _____ ft. capacity _____ g.p.m. Type: <input type="checkbox"/> Submersible <input type="checkbox"/> Turbine <input type="checkbox"/> Jet <input type="checkbox"/> Reciprocating <input type="checkbox"/> Centrifugal <input type="checkbox"/> Other
(Use a second sheet if needed)					
18. Elevation: 1310 ft Topography: <input type="checkbox"/> Hill <input type="checkbox"/> Slope <input checked="" type="checkbox"/> Upland <input type="checkbox"/> Valley	19. Remarks:		20. Water well contractor's certification: This well was drilled under my jurisdiction and this report is true to the best of my knowledge and belief. GEO COX + SONS INC 258 Business name License No. Address GLIFTON, KANS Signed Randy Cox Date 7/8/76 Authorized representative		

T
R
W
E
32
SW NE NE
1/4 1/4 1/4
Sec