


USE TYPEWRITER OR BALL POINT PEN-PRESS FIRMLY, PRINT CLEARLY.

WATER WELL RECORD
KSA 82a-1201-1215

Kansas Department of Health and Environment-Division of Environment (Water well Contractors) Topeka, Kansas 66620

1. Location of well: County **WASHINGTON** Fraction **NW 1/4 SW 1/4 SE 1/4** Section number **32** Township number **T 2 S R 3** Range number **EW**

2. Distance and direction from nearest town or city: **3 W 1 N** Street address of well location if in city: **WASHINGTON** 3. Owner of well: **MARVIN STIGGE** R.R. or street: City, state, zip code: **WASHINGTON, KANS 66968**

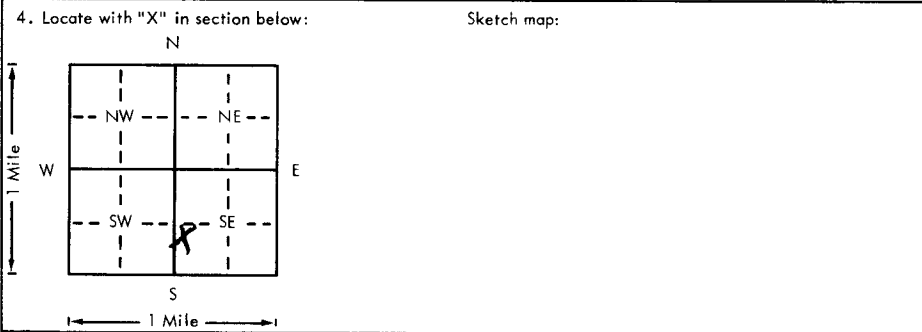

6. Bore hole dia. **8** in. Completion date **8-23-79**
Well depth **120** ft.
7. Cable tool Rotary Driven Dug
 Hollow rod Jetted Bored Reverse rotary
8. Use: Domestic Public supply Industry
 Irrigation Air conditioning Stock
 Lawn Oil field water Other
9. Casing: Material **PVC** Height: **Above** or below
Threaded Welded Surface **12** in.
RMP PVC Weight **3** lbs./ft.
Dia. **5** in. to **120** ft. depth Wall Thickness: inches or
Dia. in. to ft. depth gage No. **1258**

5. Type and color of material	From	To
TOPSOIL	0	3
SANDROCK (DRY)	3	75
RED CLAY	75	81
SANDROCK	81	120
STOP	120	

10. Screen: Manufacturer's name **PUMPCO**
Type **PVC** Dia. **5"**
Slot gauge **1/16** Length **20'**
Set between **100** ft. and **120** ft.
ft. and ft.
Gravel pack? **YES** Size range of material **1/4 x 1/4**
11. Static water level: mo./day/yr.
75 ft. below land surface Date **8-23-79**
12. Pumping level below land surfaces:
 ft. after hrs. pumping g.p.m.
 ft. after **NA** hrs. pumping g.p.m.
Estimated maximum yield **30** g.p.m.
13. Water sample submitted: Yes No Date
14. Well head completion:
 Pitless adapter **12** Inches above grade
15. Well grouted? **YES**
With: Neat cement Bentonite Concrete
Depth: From **0** ft. to **10** ft.
16. Nearest source of possible contamination: **BARN**
ft. **150** Direction **N** Type **YARD**
Well disinfected upon completion? Yes No
17. Pump: Not installed
Manufacturer's name
Model number HP Volts
Length of drop pipe ft. capacity g.p.m.
Type:
 Submersible Turbine
 Jet Reciprocating
 Centrifugal Other

18. Elevation: Topography: Hill Slope Upland Valley
19. Remarks: (Use a second sheet if needed)
20. Water well contractor's certification:
This well was drilled under my jurisdiction and this report is true to the best of my knowledge and belief.
DARYL COX & SONS INC 359
Business name License No.
Address **CUFTON, KANS 66937**
Signed **Daryl Cox** Date **8-28-79**
Authorized representative