WATER WELL RECORD Form WWC-5 KSA 82a-1212

PS

1 LOCATION OF WATER WELL: County: WASHINGTON | Fraction: SW ¼ NW ¼ NW ¼ | Section Number: 34 | Township Number: T 2 S | Range Number: R 3 E/W

Distance and direction from nearest town or city street address of well if located within city? 1½ W - 1 3/4 N Washington

2 WATER WELL OWNER: WASHINGTON CO. RWD #3 WELL #1

RR#, St. Address, Box # : BOX 175

City, State, ZIP Code : HANOVER, KS. 66945

Board of Agriculture, Division of Water Resources Application Number:

3 LOCATE WELL'S LOCATION WITH AN "X" IN SECTION BOX:

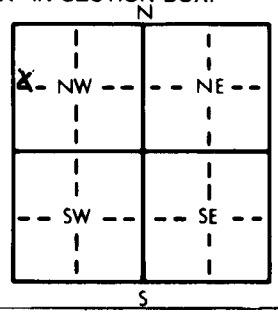

4 DEPTH OF COMPLETED WELL 118 ft. ELEVATION:

Depth(s) Groundwater Encountered 1. 70 ft. 2. ft. 3. ft.

WELL'S STATIC WATER LEVEL 63 ft. below land surface measured on mo/day/yr 11-17-82

Pump test data: Well water was 93 ft. after 1 hours pumping 150 gpm

Est. Yield 150 gpm: Well water was 93-11 ft. after 8 hours pumping 150 gpm

Bore Hole Diameter 16 in. to 118 ft., and in. to ft.

WELL WATER TO BE USED AS: 5 Public water supply 8 Air conditioning 11 Injection well
1 Domestic 3 Feedlot 6 Oil field water supply 9 Dewatering 12 Other (Specify below)
2 Irrigation 4 Industrial 7 Lawn and garden only 10 Observation well

Was a chemical/bacteriological sample submitted to Department? Yes ✓ No ; If yes, mo/day/yr sample was submitted Water Well Disinfected? Yes ✓ No

5 TYPE OF BLANK CASING USED: 1 Steel ✓ 2 PVC 3 RMP (SR) 4 ABS 5 Wrought iron 6 Asbestos-Cement 7 Fiberglass 8 Concrete tile 9 Other (specify below)

CASING JOINTS: Glued Clamped Welded ✓ Threaded

Blank casing diameter 8 in. to 98 ft., Dia in. to ft., Dia in. to ft.

Casing height above land surface 36 in., weight 28.55 lbs./ft. Wall thickness or gauge No. .322

TYPE OF SCREEN OR PERFORATION MATERIAL: 1 Steel 2 Brass 3 Stainless steel ✓ 4 Galvanized steel 5 Fiberglass 6 Concrete tile 7 PVC 8 RMP (SR) 9 ABS 10 Asbestos-cement 11 Other (specify) 12 None used (open hole)

SCREEN OR PERFORATION OPENINGS ARE: JOHNSON .025 1 Continuous slot 2 Louvered shutter 3 Mill slot 4 Key punched 5 Gauzed wrapped 6 Wire wrapped ✓ 7 Torch cut 8 Saw cut 9 Drilled holes 10 Other (specify) 11 None (open hole)

SCREEN-PERFORATED INTERVALS: From 98 ft. to 118 ft., From ft. to ft.

From ft. to ft., From ft. to ft.

GRAVEL PACK INTERVALS: From 20 ft. to 118 ft., From ft. to ft.

From ft. to ft., From ft. to ft.

6 GROUT MATERIAL: 1 Neat cement ✓ 2 Cement grout 3 Bentonite 4 Other

Grout Intervals: From 0 ft. to 20 ft., From ft. to ft., From ft. to ft.

What is the nearest source of possible contamination:
1 Septic tank 2 Sewer lines 3 Watertight sewer lines 4 Lateral lines 5 Cess pool 6 Seepage pit 7 Pit privy 8 Sewage lagoon 9 Feedyard 10 Livestock pens 11 Fuel storage 12 Fertilizer storage 13 Insecticide storage 14 Abandoned water well 15 Oil well/Gas well 16 Other (specify below)

Direction from well? OPEN FIELD How many feet?

FROM	TO	LITHOLOGIC LOG	FROM	TO	LITHOLOGIC LOG
0	3	TOP SOIL			
3	22	CLAY, BROWN			
22	57	SANDY CLAY, BROWN			
57	68	SANDSTONE, VERY SOFT			
68	117	SANDSTONE, YELLOW, FIRM			
117	120	SHALE, GREY			

7 CONTRACTOR'S OR LANDOWNER'S CERTIFICATION: This water well was (1) constructed, (2) reconstructed, or (3) plugged under my jurisdiction and was completed on (mo/day/year) 11-17-82 and this record is true to the best of my knowledge and belief. Kansas Water Well Contractor's License No. 182 This Water Well Record was completed on (mo/day/yr) 12-6-82 under the business name of STRADER DRLG. CO., INC. by (signature) Dale Askeren

INSTRUCTIONS: Use typewriter or ball point pen, PLEASE PRESS FIRMLY and PRINT clearly. Please fill in blanks, underline or circle the correct answers. Send top three copies to Kansas Department of Health and Environment, Division of Environment, Environmental Geology Section, Topeka, KS 66620. Send one to WATER WELL OWNER and retain one for your records.

OFFICE USE ONLY