


COPY FS

1 LOCATION OF WATER WELL: Fraction NW 1/4 NW 1/4 NW 1/4 Section Number 34 Township Number T 2 S Range Number R 3 E

County: Washington Distance and direction from nearest town or city street address of well if located within city? 1 1/2 W 2N OF WASHINGTON

2 WATER WELL OWNER: Washington Co. RWD #1 Well # 2
 RR#, St. Address, Box #: Box 175
 City, State, ZIP Code: Hanover, Kansas 66945
 Board of Agriculture, Division of Water Resources
 Application Number:

3 LOCATE WELL'S LOCATION WITH AN "X" IN SECTION BOX: DEPTH OF COMPLETED WELL 114 ft. ELEVATION: 1350 ft.

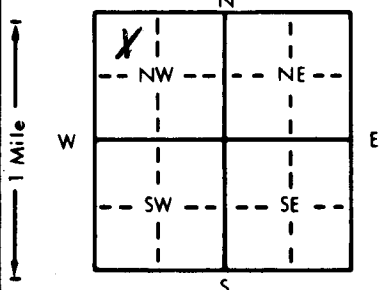

Depth(s) Groundwater Encountered 1. 44 ft. 2. 60 ft. 3. ft.
 WELL'S STATIC WATER LEVEL 56 ft. below land surface measured on mo/day/yr 5-12-82
 Pump test data: Well water was 73-114 ft. after 1 hours pumping 100 gpm
 Est. Yield 100 gpm Well water was 73-31 ft. after 8 hours pumping 100 gpm
 Bore Hole Diameter 15 in. to 114 ft., and in. to ft.
 WELL WATER TO BE USED AS:
 5 Public water supply 8 Air conditioning 11 Injection well
 1 Domestic 3 Feedlot 6 Oil field water supply 9 Dewatering 12 Other (Specify below)
 2 Irrigation 4 Industrial 7 Lawn and garden only 10 Observation well
 Was a chemical/bacteriological sample submitted to Department? Yes No; If yes, mo/day/yr sample was submitted June 2 1982 Water Well Disinfected? Yes No

5 TYPE OF BLANK CASING USED:
 1 Steel 3 RMP (SR) 5 Wrought iron 8 Concrete tile CASING JOINTS: Glued Clamped
 2 PVC 4 ABS 6 Asbestos-Cement 9 Other (specify below) Welded
 7 Fiberglass Threaded

Blank casing diameter 8 in. to 0-90 ft., Dia in. to ft., Dia in. to ft.
 Casing height above land surface 36 in., weight 28.55 lbs./ft. Wall thickness or gauge No. 322

TYPE OF SCREEN OR PERFORATION MATERIAL:
 1 Steel 3 Stainless steel Johnson .035 7 PVC 10 Asbestos-cement
 2 Brass 4 Galvanized steel 5 Fiberglass 8 RMP (SR) 11 Other (specify)
 6 Concrete tile 9 ABS 12 None used (open hole)

SCREEN OR PERFORATION OPENINGS ARE:
 1 Continuous slot 3 Mill slot 5 Gauzed wrapped 8 Saw cut 11 None (open hole)
 2 Louvered shutter 4 Key punched 6 Wire wrapped 9 Drilled holes
 7 Torch cut 10 Other (specify)

SCREEN-PERFORATED INTERVALS: From 94 ft. to 114 ft. From ft. to ft.
 GRAVEL PACK INTERVALS: From 20 ft. to 114 ft. From ft. to ft.

6 GROUT MATERIAL: 1 Neat cement 2 Cement grout 3 Bentonite 4 Other
 Grout Intervals: From 0 ft. to 20 ft., From ft. to ft., From ft. to ft.

What is the nearest source of possible contamination:
 1 Septic tank 4 Lateral lines 7 Pit privy 10 Livestock pens 14 Abandoned water well
 2 Sewer lines 5 Cess pool 8 Sewage lagoon 11 Fuel storage 15 Oil well/Gas well
 3 Watertight sewer lines 6 Seepage pit 9 Feedyard 12 Fertilizer storage 16 Other (specify below) Bare Field
 13 Insecticide storage

Direction from well? How many feet?

| FROM | TO | LITHOLOGIC LOG | FROM | TO | LITHOLOGIC LOG |
|------|-----|-------------------|------|----|----------------|
| 0 | 4 | TOP SOIL | | | |
| 4 | 20 | Clay, brown sandy | | | |
| 20 | 28 | Clay, brown | | | |
| 28 | 31 | Clay, gray | | | |
| 31 | 42 | ll brown | | | |
| 42 | 60 | SOFT SAND, STONE | | | |
| 60 | 114 | SANDSTONE | | | |

7 CONTRACTOR'S OR LANDOWNER'S CERTIFICATION: This water well was (1) constructed, (2) reconstructed, or (3) plugged under my jurisdiction and was completed on (mo/day/year) 5-12-82 and this record is true to the best of my knowledge and belief. Kansas Water Well Contractor's License No. 182 This Water Well Record was completed on (mo/day/yr) 8-11-82 under the business name of Steader Drilling Co., Inc. by (signature) Dale Askren

INSTRUCTIONS: Use typewriter or ball point pen, PLEASE PRESS FIRMLY and PRINT clearly. Please fill in blanks, underline or circle the correct answers. Send top three copies to Kansas Department of Health and Environment, Division of Environment, Environmental Geology Section, Topeka, KS 66620. Send one to WATER WELL OWNER and retain one for your records.