


1 LOCATION OF WATER WELL: Fraction SW 1/4 SW 1/4 SE 1/4 Section Number 33 Township Number T 2 S Range Number R 4 E

County: Washington Distance and direction from nearest town or city street address of well if located within city?
2 East, 1/2 North, 2 East of Washington

2 WATER WELL OWNER: Dick Panbacker Board of Agriculture, Division of Water Resources
RR#, St. Address, Box #: Washington, Kansas 66968 Application Number:
City, State, ZIP Code

3 LOCATE WELL'S LOCATION WITH AN "X" IN SECTION BOX:

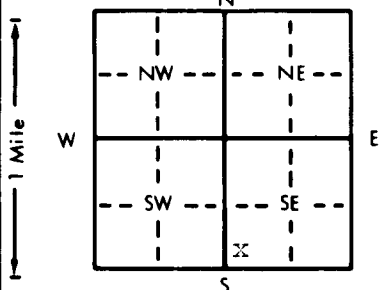

4 DEPTH OF COMPLETED WELL: 32 ft. ELEVATION:
Depth(s) Groundwater Encountered 1. ft. 2. ft. 3. ft.
WELL'S STATIC WATER LEVEL: 22 ft. below land surface measured on mo/day/yr 12/7/1982

Pump test data: Well water was NA ft. after hours pumping gpm
Est. Yield 5 gpm: Well water was ft. after hours pumping gpm
Bore Hole Diameter 8 in. to 32 ft., and in. to ft.
WELL WATER TO BE USED AS: 5 Public water supply 8 Air conditioning 11 Injection well
XX1 Domestic 3 Feedlot 6 Oil field water supply 9 Dewatering 12 Other (Specify below)
2 Irrigation 4 Industrial 7 Lawn and garden only 10 Observation well
Was a chemical/bacteriological sample submitted to Department? Yes No X; If yes, mo/day/yr sample was submitted Water Well Disinfected? Yes X No

5 TYPE OF BLANK CASING USED: 5 Wrought iron 8 Concrete tile CASING JOINTS: Glued Clamped
1 Steel 3 RMP (SR) 6 Asbestos-Cement 9 Other (specify below) Welded
XX PVC 4 ABS 7 Fiberglass Threaded

Blank casing diameter 5 in. to 12 ft., Dia in. to ft., Dia in. to ft.
Casing height above land surface 12 in., weight 3 lbs./ft. Wall thickness or gauge No. 258

TYPE OF SCREEN OR PERFORATION MATERIAL: XX7 PVC 10 Asbestos-cement
1 Steel 3 Stainless steel 5 Fiberglass 8 RMP (SR) 11 Other (specify)
2 Brass 4 Galvanized steel 6 Concrete tile 9 ABS 12 None used (open hole)

SCREEN OR PERFORATION OPENINGS ARE: 5 Gauzed wrapped XX8 Saw cut 11 None (open hole)
1 Continuous slot 3 Mill slot 6 Wire wrapped 9 Drilled holes
2 Louvered shutter 4 Key punched 7 Torch cut 10 Other (specify)

SCREEN-PERFORATED INTERVALS: From 12 ft. to 32 ft., From ft. to ft.
GRAVEL PACK INTERVALS: From 13 ft. to 32 ft., From ft. to ft.

6 GROUT MATERIAL: XX1 Neat cement 2 Cement grout 3 Bentonite 4 Other
Grout Intervals: From 3 ft. to 13 ft., From ft. to ft., From ft. to ft.

What is the nearest source of possible contamination: XX10 Livestock pens 14 Abandoned water well
1 Septic tank 4 Lateral lines 7 Pit privy 11 Fuel storage 15 Oil well/Gas well
2 Sewer lines 5 Cess pool 8 Sewage lagoon 12 Fertilizer storage 16 Other (specify below)
3 Watertight sewer lines 6 Seepage pit 9 Feedyard 13 Insecticide storage

Direction from well? West How many feet? 100

FROM	TO	LITHOLOGIC LOG	FROM	TO	LITHOLOGIC LOG
0	3	topsoil			
3	6	brown clay			
6	15	sandy brown clay			
15	20	blue clay w/ rock layers			
20	24	sandrock gravel			
24	26	limestone gravel			
26	30	limestone (hard)			
30	32	blue shale w/ gypsum			
32		stop			

7 CONTRACTOR'S OR LANDOWNER'S CERTIFICATION: This water well was ~~not~~ constructed, (2) reconstructed, or (3) plugged under my jurisdiction and was completed on (mo/day/year) 12/7/1982 and this record is true to the best of my knowledge and belief. Kansas Water Well Contractor's License No. 359 This Water Well Record was completed on (mo/day/yr) 12/28/1982 under the business name of Daryl Cox & Sons Inc. by (signature) Daryl Cox

INSTRUCTIONS: Use typewriter or ball point pen, PLEASE PRESS FIRMLY and PRINT clearly. Please fill in blanks, underline or circle the correct answers. Send top three copies to Kansas Department of Health and Environment, Division of Environment, Environmental Geology Section, Topeka, KS 66620. Send one to WATER WELL OWNER and retain one for your records.