


WATER WELL RECORD Form WWC-5 KSA 82a-1212

1 LOCATION OF WATER WELL:
County: Washington
Fraction: SW 1/4 SE 1/4 NE 1/4
Section Number: 9
Township Number: T 2 S
Range Number: R 5 E/W

2 WATER WELL OWNER: Bill's Service Center
RR#, St. Address, Box #: 2832 Hilltop Avenue
City, State, ZIP Code: Hanover, Kansas 66945
Board of Agriculture, Division of Water Resources
Application Number:

3 LOCATE WELL'S LOCATION WITH AN "X" IN SECTION BOX:

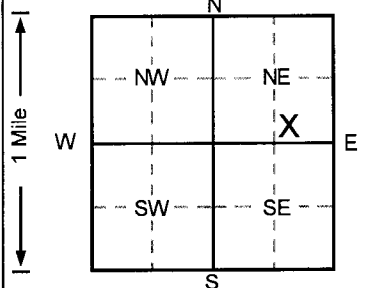

4 DEPTH OF COMPLETED WELL: 50 ft. ELEVATION: 1292.62
WELL'S STATIC WATER LEVEL: 46.72 ft. below land surface measured on mo/day/yr 2/18/97
Pump test data: Well water was NA ft. after ... hours pumping ... gpm
Est. Yield NA gpm: Well water was ... ft. after ... hours pumping ... gpm
WELL WATER TO BE USED AS: 10 Monitoring well

5 TYPE OF BLANK CASING USED: 2 PVC
Blank casing diameter: 2 in. to 35 ft., Dia ... in. to ... ft., Dia ... in. to ... ft.
TYPE OF SCREEN OR PERFORATION MATERIAL: 7 PVC
SCREEN OR PERFORATION OPENINGS ARE: 3 Mill slot
SCREEN-PERFORATED INTERVALS: From 35 ft. to 50 ft.

6 GROUT MATERIAL: 2 Cement grout 3 Bentonite
Grout Intervals: From 0 ft. to 28 ft., From 28 ft. to 31 ft.
What is the nearest source of possible contamination: 16 Other (specify below) AST Basin

Table with columns: LITHOLOGIC LOG (FROM, TO, Description) and PLUGGING INTERVALS. Includes well depth markers and soil layer descriptions like Clay, Dark Brown and Shale, Green to Gray.

7 CONTRACTOR'S OR LANDOWNER'S CERTIFICATION: This water well was 1 constructed, and was completed on 2/11/97
Kansas Water Well Contractor's License No. 527
under the business name of GeoCore Services, Inc.