


WATER WELL RECORD Form WWC-5 KSA 82a-1212

Table with 4 columns: LOCATION OF WATER WELL, Fraction, Section Number, Township Number, Range Number. Includes County: Washington, Fraction: NW 1/4, NE 1/4, SE 1/4, Section Number: 9, Township Number: T 2 S, Range Number: R 5 E/W.

Distance and direction from nearest town or city street address of well if located within city? 1/4 mile East of Hanover, Kansas

2 WATER WELL OWNER: Bill's Service Center
RR#, St. Address, Box #: 2832 Hilltop Avenue
City, State, ZIP Code: Hanover, Kansas 66945
Board of Agriculture, Division of Water Resources
Application Number:

3 LOCATE WELL'S LOCATION WITH AN "X" IN SECTION BOX:

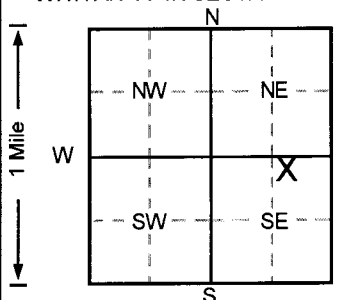

4 DEPTH OF COMPLETED WELL: 50 ft. ELEVATION: 1290.85
Depth(s) Groundwater Encountered 1: 44 ft. 2: ft. 3: ft.
WELL'S STATIC WATER LEVEL: 41.89 ft. below land surface measured on mo/day/yr 2/18/97
Pump test data: Well water was NA ft. after ... hours pumping ... gpm
Est. Yield NA gpm: Well water was ... ft. after ... hours pumping ... gpm
Bore Hole Diameter: 8 in. to 50 ft., and ... in. to ... ft.
WELL WATER TO BE USED AS: 5 Public water supply 8 Air conditioning 11 Injection well
1 Domestic 3 Feedlot 6 Oil field water supply 9 Dewatering 12 Other (Specify below)
2 Irrigation 4 Industrial 7 Lawn and garden only 10 Monitoring well
Was a chemical/bacteriological sample submitted to Department? Yes.....No✓; If yes, mo/day/yr sample was submitted
Water Well Disinfected? Yes No✓

5 TYPE OF BLANK CASING USED: 1 Steel 2 PVC 3 RMP (SR) 4 ABS 5 Wrought iron 6 Asbestos-Cement 7 Fiberglass 8 Concrete tile 9 Other (specify below)
Blank casing diameter: 2 in. to 30 ft., Dia ... in. to ... ft., Dia ... in. to ... ft.
Casing height above land surface: 27.6 in., weight ... lbs./ft. Wall thickness or gauge No. Sch. 40
TYPE OF SCREEN OR PERFORATION MATERIAL: 1 Steel 2 Brass 3 Stainless steel 4 Galvanized steel 5 Fiberglass 6 Concrete tile 7 PVC 8 RMP (SR) 9 ABS 10 Asbestos-cement 11 Other (specify) 12 None used (open hole)
SCREEN OR PERFORATION OPENINGS ARE: 1 Continuous slot 2 Louvered shutter 3 Mill slot 4 Key punched 5 Gauzed wrapped 6 Wire wrapped 7 Torch cut 8 Saw cut 9 Drilled holes 11 None (open hole) 10 Other (specify)
SCREEN-PERFORATED INTERVALS: From 30 ft. to 50 ft., From ... ft. to ... ft.
GRAVEL PACK INTERVALS: From 27 ft. to 50 ft., From ... ft. to ... ft.

6 GROUT MATERIAL: 1 Neat cement 2 Cement grout 3 Bentonite 4 Other
Grout Intervals: From 0 ft. to 25 ft., From 25 ft. to 27 ft., From ... ft. to ... ft.
What is the nearest source of possible contamination: 1 Septic tank 2 Sewer lines 3 Watertight sewer lines 4 Lateral lines 5 Cess pool 6 Seepage pit 7 Pit privy 8 Sewage lagoon 9 Feedyard 10 Livestock pens 11 Fuel storage 12 Fertilizer storage 13 Insecticide storage 14 Abandoned water well 15 Oil well/Gas well 16 Other (specify below) AST Basin
Direction from well? NE How many feet? 380

Table with columns FROM, TO, LITHOLOGIC LOG, FROM, TO, PLUGGING INTERVALS. Rows show lithology from 0-17 feet (Clay, Dark Brown), 17-33 feet (Clay, Light Green to Light Gray), 33-50 feet (Shale, Red Brown), and 50-50 feet (Shale, Green Gray). Also includes MW10, Tag # 00181268, Abovegrade and Project Name: Bill's Service Center.

7 CONTRACTOR'S OR LANDOWNER'S CERTIFICATION: This water well was (1) constructed, (2) reconstructed, or (3) plugged under my jurisdiction and was completed on (mo/day/year) 2/13/97 and this record is true to the best of my knowledge and belief.
Kansas Water Well Contractor's License No. 527 This Water Well Record was completed on (mo/day/yr) 2/21/97 under the business name of GeoCore Services, Inc. by (signature)