


1] LOCATION OF WATER WELL: County: Washington Fraction SW 1/4 SE 1/4 NE 1/4 Section Number 9 Township Number T 2 S Range Number R 5 EW

Distance and direction from nearest town or city street address of well if located within city? 1/4 mile East of Hanover Kansas

2] WATER WELL OWNER: Bill's Service Center RR#, St. Address, Box #: 2832 Hilltop Avenue City, State, ZIP Code: Hanover, Kansas 66945 Board of Agriculture, Division of Water Resources Application Number:

3] LOCATE WELL'S LOCATION WITH AN "X" IN SECTION BOX:

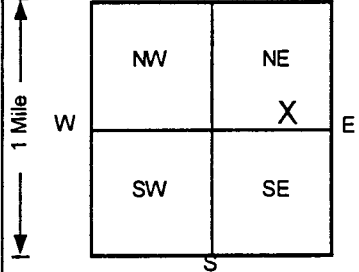

4] DEPTH OF COMPLETED WELL: 50 ft ELEVATION: 0 ft. WELL'S STATIC WATER LEVEL: 41.01 ft below land surface measured on mo/day/yr. Pump test data: Well water was NA ft after hours pumping gpm. Est Yield NA gpm. Well water was ft after hours pumping gpm. Bore Hole Diameter in. to ft, and in. to ft. WELL WATER TO BE USED AS: 5 Public water supply 8 Air conditioning 11 Injection well 1 Domestic 3 Feedlot 6 Oil field water supply 9 Dewatering 12 Other (Specify below) 2 Irrigation 4 Industrial 7 Lawn and garden only 10 Monitoring well. Was a chemical/bacteriological sample submitted to Department? Yes.....No [checked]; If yes, mo/day/yr sample was submitted. Water Well Disinfected? Yes No [checked]

5] TYPE OF BLANK CASING USED: 1 Steel 3 RMP (SR) 5 Wrought iron 8 Concrete tile CASING JOINTS: Glued Clamped 2 PVC 4 ABS 6 Asbestos-Cement 9 Other (specify below) Welded Threaded 7 Fiberglass. Blank casing diameter 2 in. to ft, Dia in. to ft, Dia in. to ft. Casing height above land surface -5.76 in., weight lbs./ft. Wall thickness or gauge No.

TYPE OF SCREEN OR PERFORATION MATERIAL: 1 Steel 3 Stainless steel 5 Fiberglass 7 PVC 8 RMP (SR) 10 Asbestos-cement 2 Brass 4 Galvanized steel 6 Concrete tile 9 ABS 12 None used (open hole) 11 Other (specify)

SCREEN OR PERFORATION OPENINGS ARE: 1 Continuous slot 3 Mill slot 5 Gauzed wrapped 8 Saw cut 11 None (open hole) 2 Louvered shutter 4 Key punched 6 Wire wrapped 9 Drilled holes 7 Torch cut 10 Other (specify)

SCREEN-PERFORATED INTERVALS: From 50 ft to 35 ft, From ft to ft, From ft to ft. GRAVEL PACK INTERVALS: From ft to ft, From ft to ft, From ft to ft

6] GROUT MATERIAL: 1 Neat cement 2 Cement grout 3 Bentonite 4 Other. Grout intervals: From 50 ft to 0 ft, From ft to ft, From ft to ft

What is the nearest source of possible contamination: 1 Septic tank 4 Lateral lines 7 Pit privy 10 Livestock pens 14 Abandoned water well 2 Sewer lines 5 Cess pool 8 Sewage lagoon 11 Fuel storage 15 Oil well/Gas well 3 Watertight sewer lines 6 Seepage pit 9 Feedyard 12 Fertilizer storage 16 Other (specify below) 13 Insecticide storage. Direction from well? How many feet? 0

Table with columns: FROM, TO, LITHOLOGIC LOG, FROM, TO, PLUGGING INTERVALS. Row 1: 50, 0, Cement/Bentonite Grout. Row 2: MW5.1, Tag #, Project Name: Bill's Service Center, GeoCore # 406, KDHE # A5 101 40078

7] CONTRACTOR'S OR LANDOWNER'S CERTIFICATION: This water well was (1) constructed, (2) reconstructed, or (3) plugged under my jurisdiction and was completed on (mo/day/year) 6/10/97 and this record is true to the best of my knowledge and belief. Kansas Water Well Contractor's License No. 527. This Water Well Record was completed on (mo/day/yr) 6/20/97 under the business name of GeoCore Services, Inc. by (signature)

OFFICE USE ONLY

T

R

EW

SEC

1/4

1/4

1/4