


1] LOCATION OF WATER WELL: County: Washington Fraction SW 1/4 SE 1/4 NE 1/4 Section Number 9 Township Number T 2 S Range Number R 5 EW

Distance and direction from nearest town or city street address of well if located within city? 1/4 mile East of Hanover Kansas

2] WATER WELL OWNER: Bill's Service Center RR#, St. Address, Box # : 2832 Hilltop Avenue Board of Agriculture, Division of Water Resources City, State, ZIP Code : Hanover, Kansas 66945 Application Number:

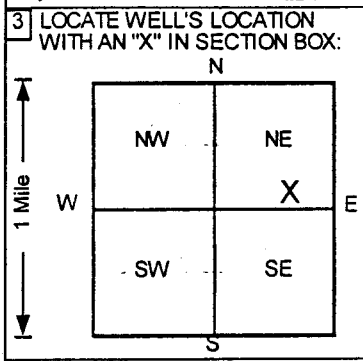

3] LOCATE WELL'S LOCATION WITH AN "X" IN SECTION BOX: 4] DEPTH OF COMPLETED WELL 55 ft ELEVATION: 0 ft

5] TYPE OF BLANK CASING USED: 1 Steel 3 RMP (SR) 5 Wrought iron 8 Concrete tile CASING JOINTS: Glued Clamped 2 PVC 4 ABS 6 Asbestos-Cement 9 Other (specify below) Welded Threaded

6] GROUT MATERIAL: 1 Neat cement 2 Cement grout 3 Bentonite 4 Other Grout Intervals: From 55 ft to 0 ft

Table with 2 main columns: LITHOLOGIC LOG and PLUGGING INTERVALS. The Lithologic Log section has columns for FROM and TO. The Plugging Intervals section has columns for FROM and TO. The table contains one row of data: FROM (blank) TO (blank) LITHOLOGIC LOG (blank) FROM (55) TO (0) PLUGGING INTERVALS (Cement/Bentonite Grout). Below this are several empty rows and a section for MW2.1, Tag #, Project Name: Bill's Service Center, and GeoCore # 406, KDHE # A5 101 40078.

7] CONTRACTOR'S OR LANDOWNER'S CERTIFICATION: This water well was (1) constructed, (2) reconstructed, or (3) plugged under my jurisdiction and was completed on (mo/day/year) 6/10/97 and this record is true to the best of my knowledge and belief.