


1 LOCATION OF WATER WELL: Fraction Section Number Township Number Range Number  
 County: WASHINGTON SE 1/4 NE 1/4 27 2 5

Distance and direction from nearest town or city street address of well if located within city?  
HANOVER is 2 mi N & 1/2 mile West

2 WATER WELL OWNER: Brant M. Lawe  
 RR#, St. Address, Box #: 2834 23RD ROAD Board of Agriculture, Division of Water Resources  
 City, State, ZIP Code: HANOVER KS 66445-9801 Application Number:

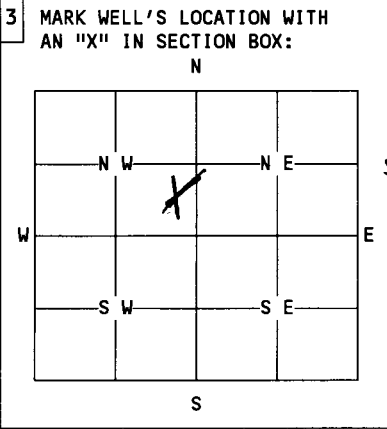

4 DEPTH OF WELL..... 23 1/2.....ft.  
 WELL'S STATIC WATER LEVEL... 20 1/2...ft. to Water  
 WELL WAS USED AS:  
 1 Domestic  5 Public Water Supply  9 Dewatering  
 2 Irrigation  6 Oil Field Water Supply  10 Monitoring Well  
 3 Feedlot  7 Lawn and Garden Only  11 Injection Well  
 4 Industrial  8 Air Conditioning  12 Other.....  
 Was a chemical/bacteriological sample submitted to Department? Yes....No....  
 If yes, mo/day/yr sample was submitted.....  
 Water Well Disinfected: Yes..... No.....

5 TYPE OF BLANK CASING USED:  
 1 Steel 3 RMP (SR) 5 Wrought 7 Fiberglass 9 Other (specify below)  
 2 PVC 4 ABS 6 Asbestos-Cement 8 Concrete Tile ROCK-HAND DUG  
 Blank casing diameter 3 3/8 in. Was casing pulled? Yes  No..... If yes, how much 5'  
 Casing height above or below land surface..... 10' in. KNOCKED IN

6 GROUT PLUG MATERIAL: 1 Neat cement 2 Cement grout 3 Bentonite 4 Other.....  
 Grout Plug Intervals: From 4.5 ft. to 5.0 ft., From.....ft. to .....ft., From..... to.....ft.

What is the nearest source of possible contamination:  
 1 Septic tank 6 Seepage pit 11 Fuel storage 16 Other (specify below)  
 2 Sewer lines 7 Pit privy 12 Fertilizer storage  
 3 Watertight sewer lines 8 Sewage lagoon 13 Insecticide storage  
 4 Lateral lines 9 Feedyard 14 Abandoned water well  
 5 Cess Pool 10 Livestock pens pasture 15 Oil well/Gas well  
 Direction from well? All directions How many feet? All sides

FROM	TO	PLUGGING MATERIALS
0	4.5	Topsoil
4.5	5.0	Plugging Grade Bentonite
5.0	20 1/2	Clay Soil
20 1/2	23 1/2	Chlorinated Sand

7 CONTRACTOR'S OR LANDOWNER'S CERTIFICATION: This water well was plugged under my jurisdiction and was completed on (mo/day/year) 12/20/1998 and this record is true to the best of my knowledge and belief. Kansas Water Well Contractor's License No. 014 This Water Well Record was completed on (mo/day/year) 1/4/1999 under the business name of Washington Co. Conservation District by (signature) [Signature]

INSTRUCTIONS: Use typewriter or ball point pen. Please press firmly and print clearly. Please fill in blanks, underline or circle the correct answers. Send top three copies to Kansas Department of Health and Environment, Bureau of Water, Topeka, Kansas 66620-0001. Telephone: 913/296-3565. Send one to Water Well Owner and retain one for your records.